


Claim of Beneficial Use - Kizer  
 Application G-16700, Permit G-16522

Township 19S, Range 3W, W.M.

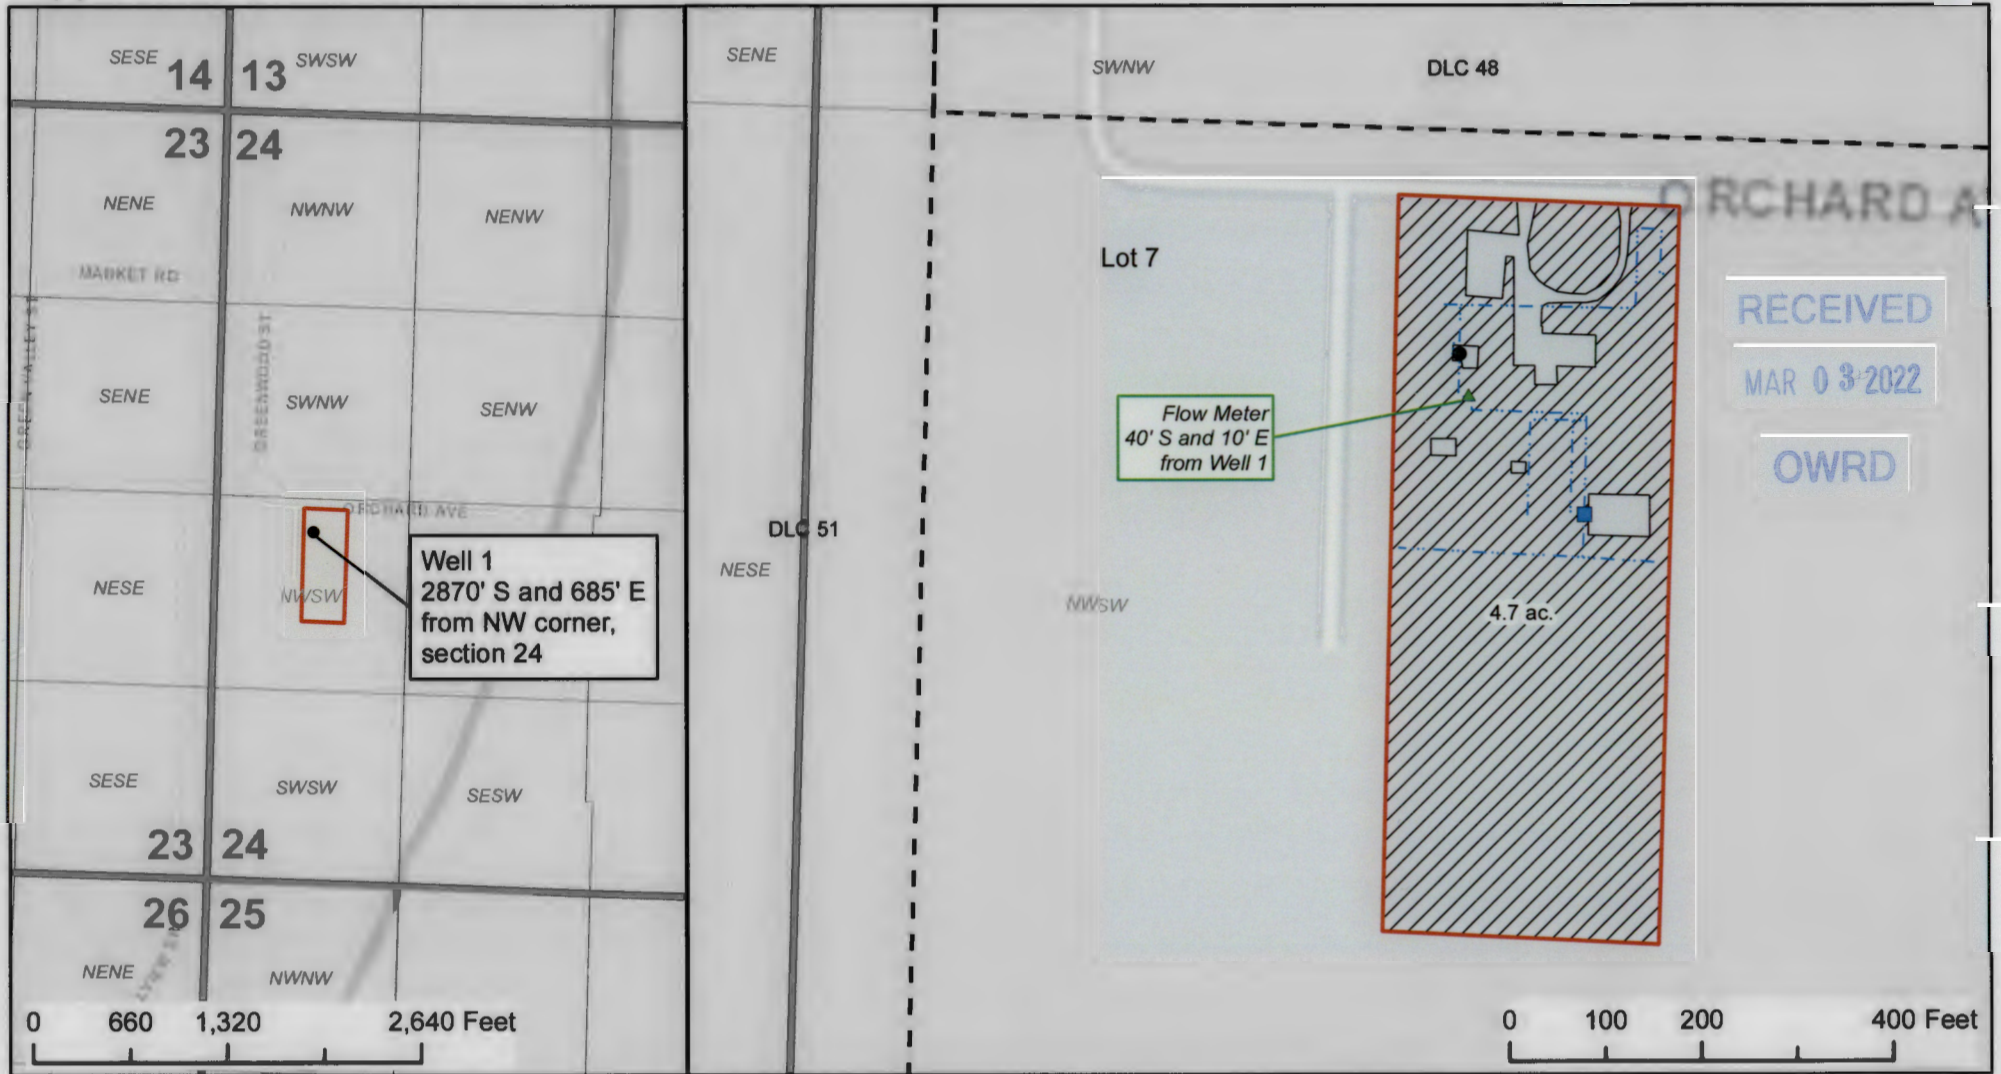

RECEIVED  
 MAR 03 2022  
 OWRD

This map is not intended to provide legal dimensions or location of property ownership lines.



Legend

- IR POU
- Well 1
- Mainline
- Flow Meter
- Storage Tank
- Taxlot 1706
- DLC

EXPIRES: 12-31-2022