


SECTION 27, T.5S, R.2E, W.M. CLACKAMAS COUNTY

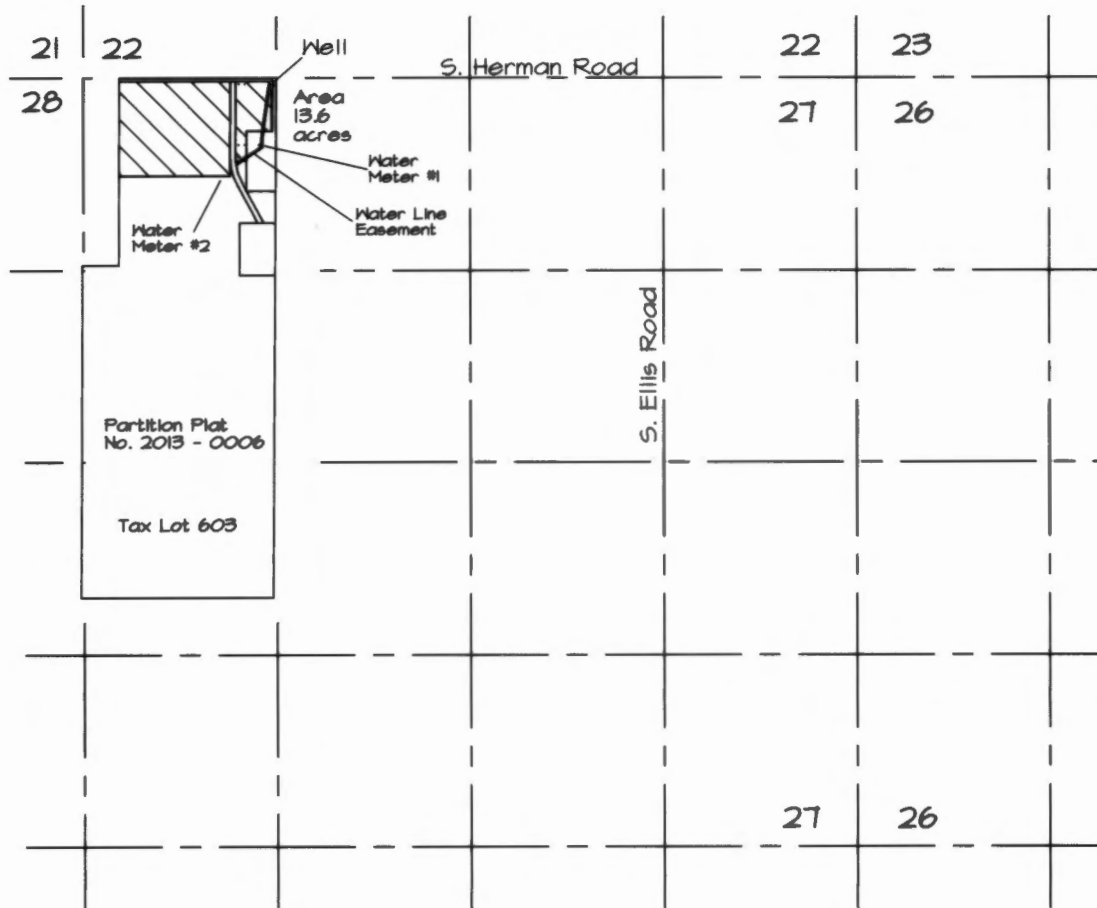

SCALE: 1" = 1320'

WELL IS 46 FEET SOUTH AND 1,288 EAST
OF THE NW CORNER OF SECTION 27.



IRRIGATED AREA
(13.6 ACRES)

BENEFICIAL USE MAP
FOR
HARLAN SHOBER
DRIZZLEWOOD FARM LLC

APPLICATION NO. G-17670
PERMIT NO. G-17174


THE PREPARATION OF THIS MAP IS FOR THE
PURPOSE OF IDENTIFYING THE LOCATION
OF THE WATER RIGHT ONLY AND HAS NO
INTENT TO PROVIDE DIMENSIONS OR LOCATION
OF PROPERTY OWNERSHIP LINES

03/19/2020

RECEIVED

APR 09 2020

OWRD

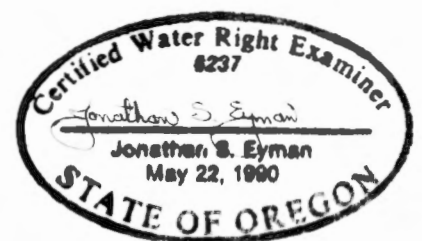

RENEWS 12-31-2021