


TOWNSHIP 2 SOUTH, RANGE 1 WEST, W.M.
SECTION 20

APPLICATION R-83470, PERMIT R-12652
STEINBORN TRACT
TUALATIN NATIONAL WILDLIFE REFUGE

1 INCH = 1320 FEET

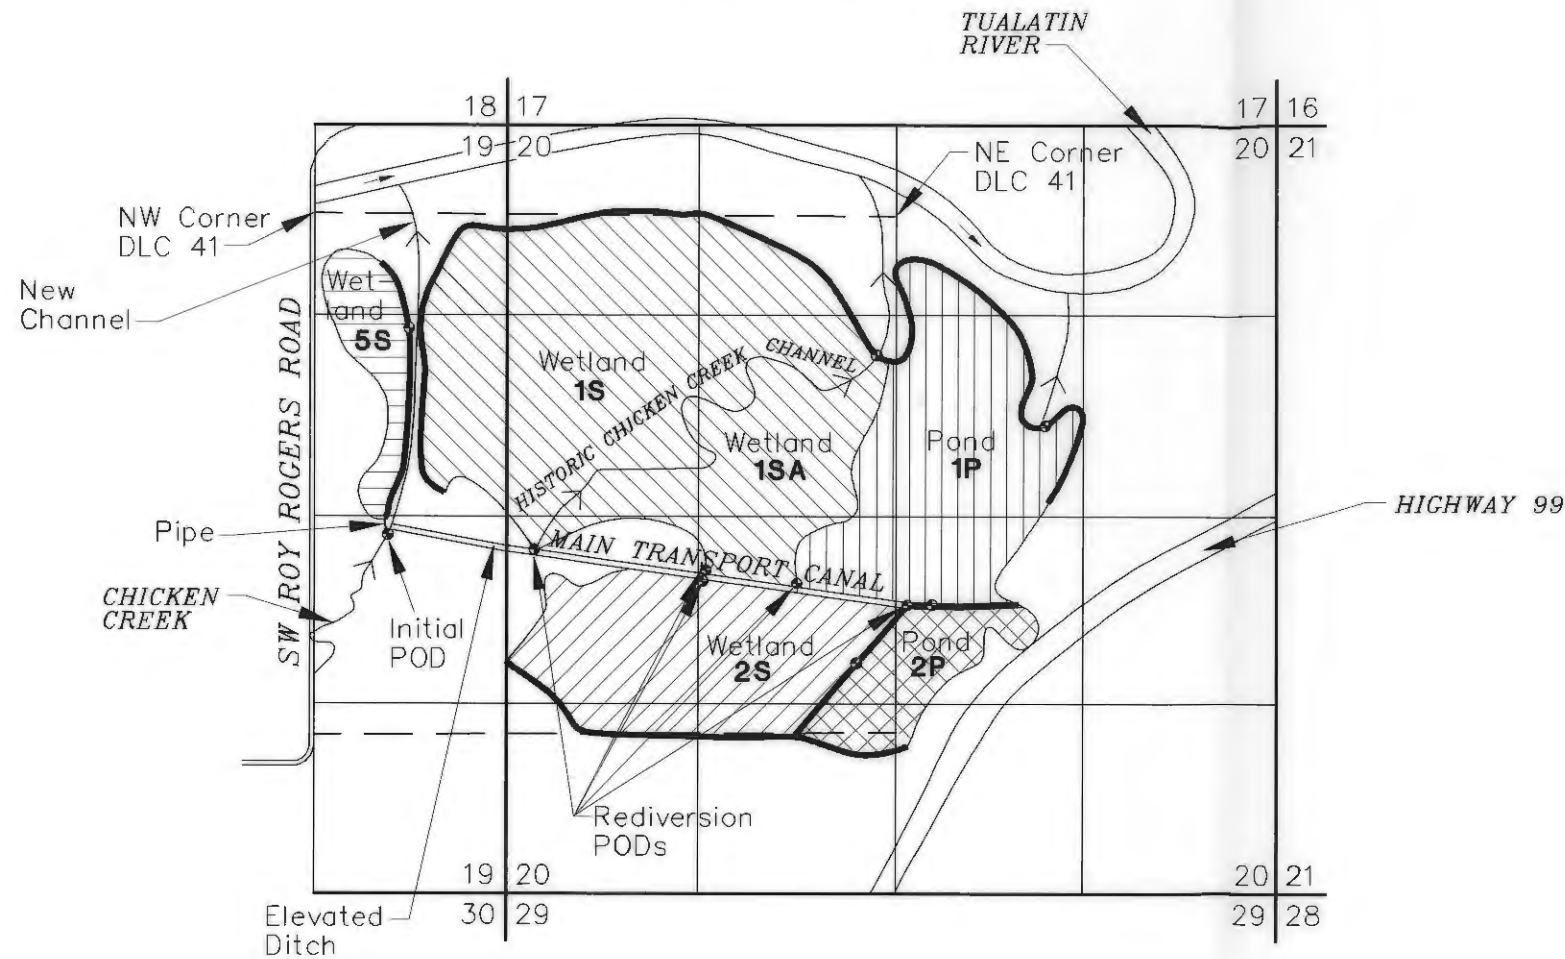

RECEIVED
MAR 03 2003
WATER RESOURCES DEPT.
SALEM, OREGON

EXPLANATION:

- PLACE OF USE
- POINT OF DIVERSION (POD)
- DLC
- DAM
- PIPE LINE

NOTES:

1. Initial POD on Chicken Creek located 2,170 feet south and 520 feet east of the NW corner of DLC 41.
2. Pond 1P POD located 1,480 feet south and 5,030 feet east of the NW corner of DLC 41.
3. Wetland 1S & 1SA POD located 1,000 feet south and 3,810 feet east of of the NW corner of DLC 41.
4. Pond 2P POD located 2,640 feet south and 4,250 feet east of the NW corner of DLC 41.
5. Wetland 2S POD located 3,110 feet south and 3,630 feet east of the NW corner of DLC 41.
6. Wetland 5S POD located 790 feet south and 630 feet east of the NW corner of DLC 41.
7. Survey completed on September 10-14 and 25, 2002.

THE PURPOSE OF THIS MAP IS TO IDENTIFY THE LOCATION OF THE WATER RIGHT. IT IS NOT INTENDED TO PROVIDE INFORMATION RELATIVE TO THE LOCATION OF PROPERTY OWNERSHIP BOUNDARY LINES.



**CLAIM OF BENEFICIAL USE MAP
U.S. FISH AND WILDLIFE SERVICE**

FIGURE 1