


IDLEWAY IMPROVEMENT DISTRICT

LOCATED IN T16S, R17E, W.M.
CROOK COUNTY, OREGON

DISCLAIMER: THIS MAP IS NOT INTENDED TO
PROVIDE LEGAL DIMENSIONS OR LOCATIONS
OF PROPERTY OWNERSHIP LINES.

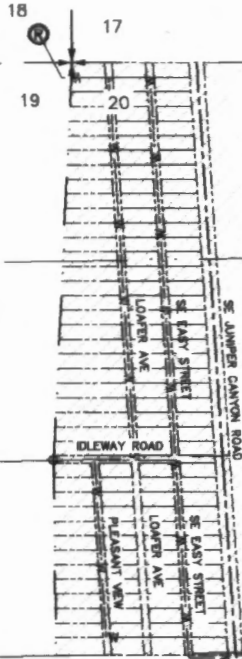

LEGEND

- PLSS SECTION LINE
- PLSS QTR-QTR LINE
- PROPERTY BOUNDARY
- ROAD CENTERLINE
- AUTHORIZED PLACE OF USE
PRIORITY DATE NOV. 20, 1987
- WATERLINE
- WELL - AUTHORIZED POA
- WATER STORAGE RESERVOIR




AUTHORIZED WELL 5 - CRO051820
1095 FT N. AND 1367 FT E. FROM $W\frac{1}{4}$
CORNER, SECTION 29

RECEIVED

MAR 09 2020


OWRD

SENSUS WATER METER LOCATED IN
SIDE OF BUILDING APPROXIMATELY 29
FEET NORTHEAST OF WELL HEAD

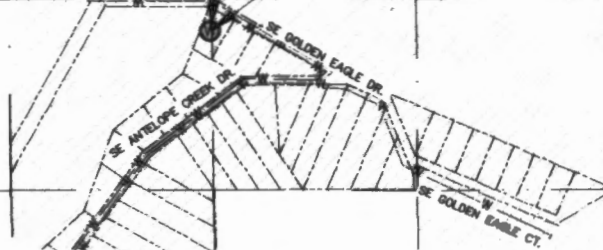

AUTHORIZED WELL 6 - CRO052334
629 FT S. AND 68 FT E. FROM
 $W\frac{1}{4}$ CORNER, SECTION 29


ZENNER WATER METER LOCATED IN
WELL HOUSE APPROXIMATELY 22
FEET SOUTHWEST OF WELL HEAD

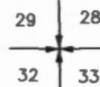

RENEWS: 12-31-21



SCALE: 1" = 1320'

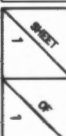

TYE ENGINEERING &
SURVEYING, INC.
725 NW HILL STREET
BEND, OREGON 97703
541-389-6959
office@bendcable.com
www.tyeengineering.com

FOR:
IDLEWAY IMPROVEMENT DISTRICT
10110 SE GOLDEN EAGLE DRIVE
PRINEVILLE, OR 97754

TITLE:
T-12998 CLAIM OF
BENEFICIAL USE

JOB NO: 2228
DATE: 02/21/20
DRAWN BY: BVV
SCALE: 1" = 1320'
DWG: 2228-IDLEWAY_10-10-18.DWG