CLAIM OF BENEFICIAL USE

LOCATED IN THE SE¼-NW¼, SW¼-NE¼, NE¼-SW¼ & NW¼-SE¼, SEC. 11, T.30S., R.15W., W.M., COOS COUNTY, OREGON

DATE: FEB. 2012

PREPARED FOR: DAVE HUGHES

PREPARED BY: STUNTZNER ENG. & FORESTRY, COOS BAY, OREGON

APPLICATION: R-73289
PERMIT: R-12108

	ACRES:	PRIMARY	SUPP.
SW-NE ACRES:	17.1 Ac.±	10.8	6.3
SE-NW ACRES:	3.3 Ac.±	2.3	1.0
TOTAL :	20.4 AC.±	13.1	7.3

AREAS OF SUMPS
SUMP 1: 0.42 Ac±
SUMP 2: 0.16 Ac±
SUMP 3: 0.64 Ac±

P.O.A.#	NORTH	EAST
#1:	710'±	940'±
#2:	1300'±	635'±
MEASURED FROM C¼ (SHOWN THUS: ----635'±----)		

PIPELINE LENGTHS SHOWN:

3"× 1600'± (BURIED)
4"× 5400'± (BURIED)
6"× 700'± (BURIED)

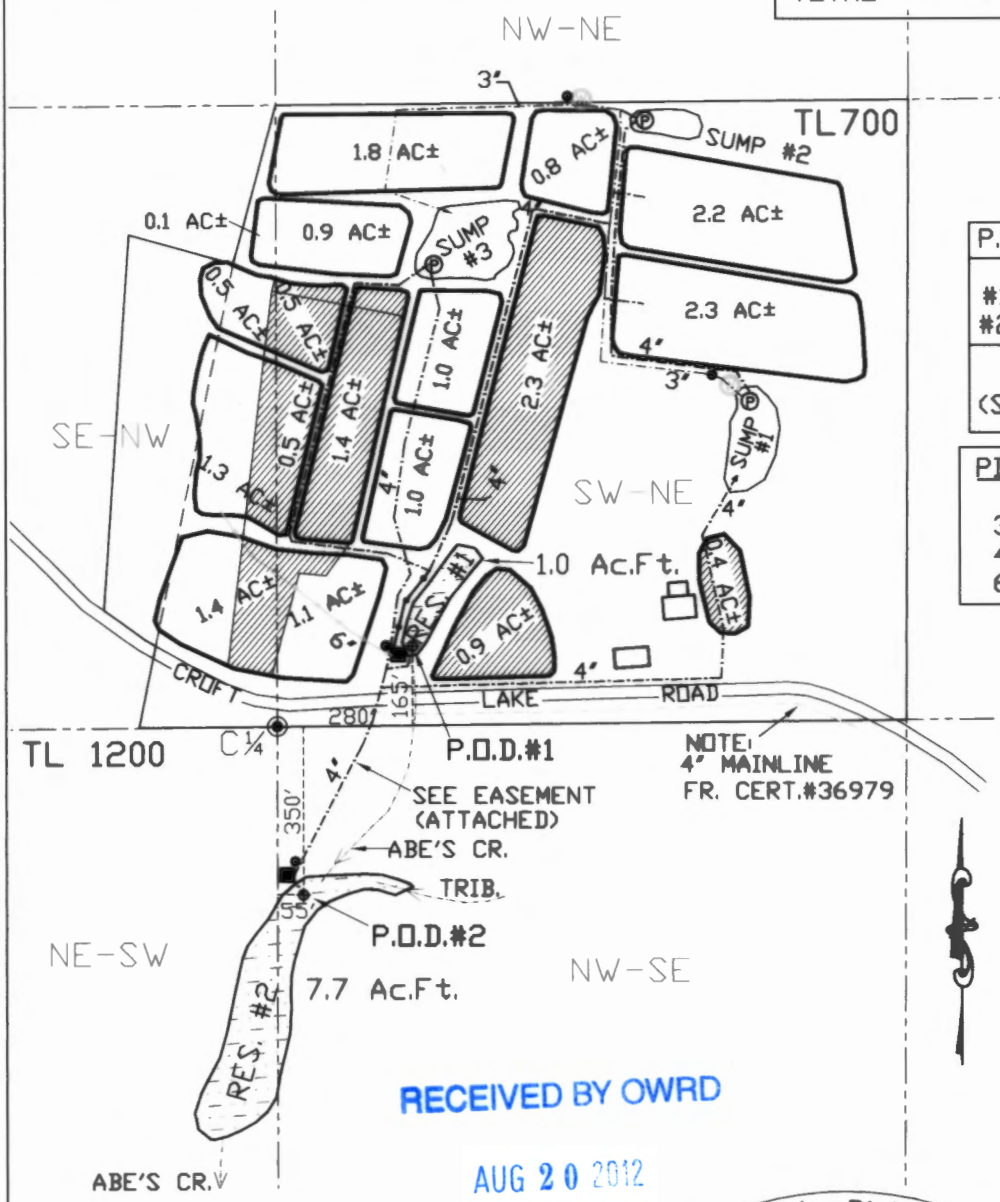

LEGEND

- GOVT. CORNER
- EXIST. BOGS
- SECTION LINE (PER ASSESSOR)
- EXIST. BUILDINGS
- EXISTING WELL
- PUMP HOUSE (FLOW METER)
- PIPELINES (6")
- PIPELINES (4" & 3" AS NOTED)
- FLOW METER
- RESERVOIRS
- SUPPLEMENTAL TO CERT. #36979
- EXISTING CREEKS
- P.O.D. (POINT OF DIVERSION)
- SURFACE PUMP

SCALE 1" = 400 FT.

400 0 160 240 320 400

RECEIVED BY OWRD
AUG 20 2012
SALEM, OR

Certified Water Right Examiner
441WRE
Thomas M. Hoshall
June 13, 1997
STATE OF OREGON

EXPIRES 06/30/2013

THE PREPARATION OF THIS MAP WAS FOR THE PURPOSE OF IDENTIFYING THE LOCATION OF THE WATER RIGHT ONLY AND HAS NO INTENT TO PROVIDE DIMENSIONS OR LOCATION OF PROPERTY OWNERSHIP.

Stuntzner Engineering & Forestry, L.L.C.
ENGINEERING • LAND SURVEYING • FORESTRY
PLANNING • WATER RIGHTS
705 South 4th St.
Post Office Box 116
Coos Bay, Oregon 97420
Phone: (541) 267-2872
Fax: (541) 267-0586

Drawn By:	Elvin Stingley	Date:	February 2012
Checked By:	TMH	Drawing No.:	12-3-005
Designed By:		Revised:	
Job Name:	Hughes CORU - Reservoir		Sheet 2 of 2