



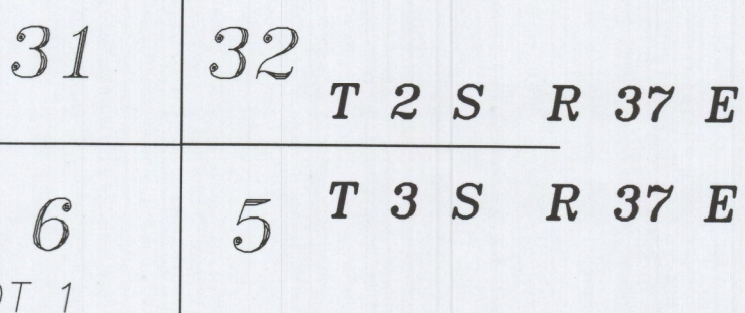

DETAIL

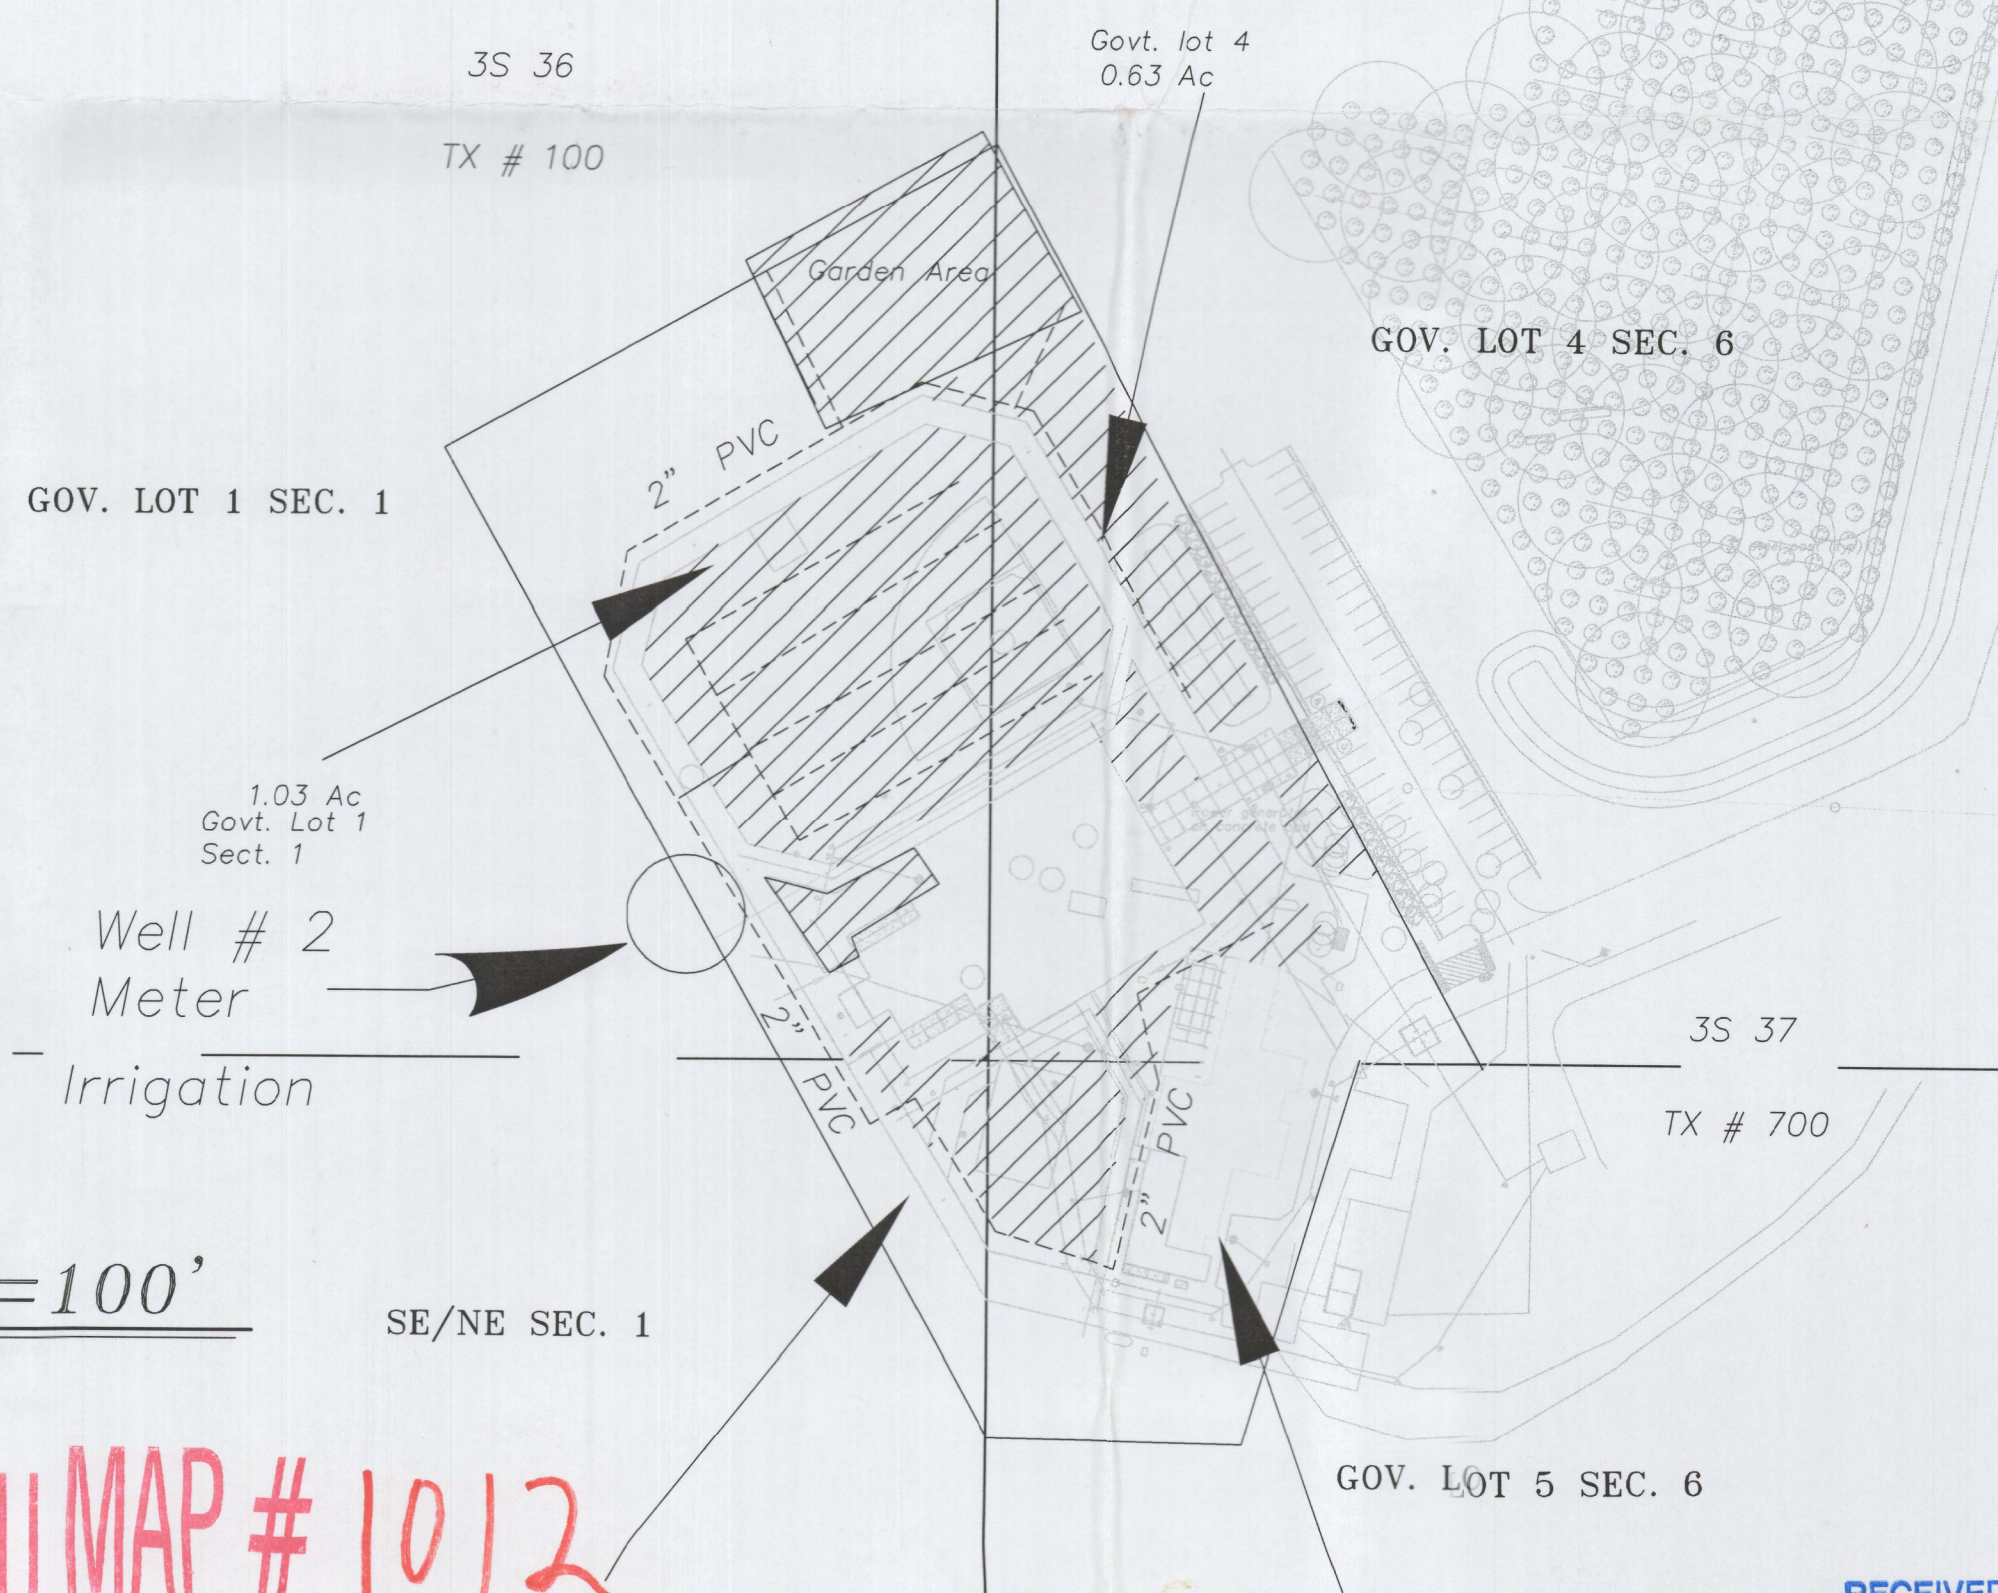

SCALE: 1"=100'

COBU MAP # 1012

RECEIVED BY OWRD

AUG 03 2016

SALEM, OR

Certified Water Right Examiner
021
Gregory T. Blackman
Gregory T. Blackman
Nov. 19, 1987
STATE OF OREGON

JUNE 2, 2016

CLAIM OF BENEFICIAL USE MAP FOR
WATER RIGHTS FROM A WELL AS
APPROVED UNDER PERMIT G-15544
FOR
OREGON YOUTH AUTHORITY
BY
GREG BLACKMAN WATER RIGHTS
126 RIDGE DRIVE
LA GRANDE, OREGON 97850

APPLICATION NO.	G-15869
PERMIT NUMBER	G-15544