

RECEIVED

SEP 26 1994

WATER RESOURCES DEPT
SALEM, OREGON

T. 31 S., R. 12 W.

Sec. 12 SW 1/4 SE 1/4
FINAL PROOF SURVEY

Application No. 70223

Permit No. 51142


IN THE NAME OF

Surveyed on Sept 2, 1994 By
Scale: 1" = 400ft.



System Capacity is limited by
flow; which was about 0.002 CFS.

* DLC # 37

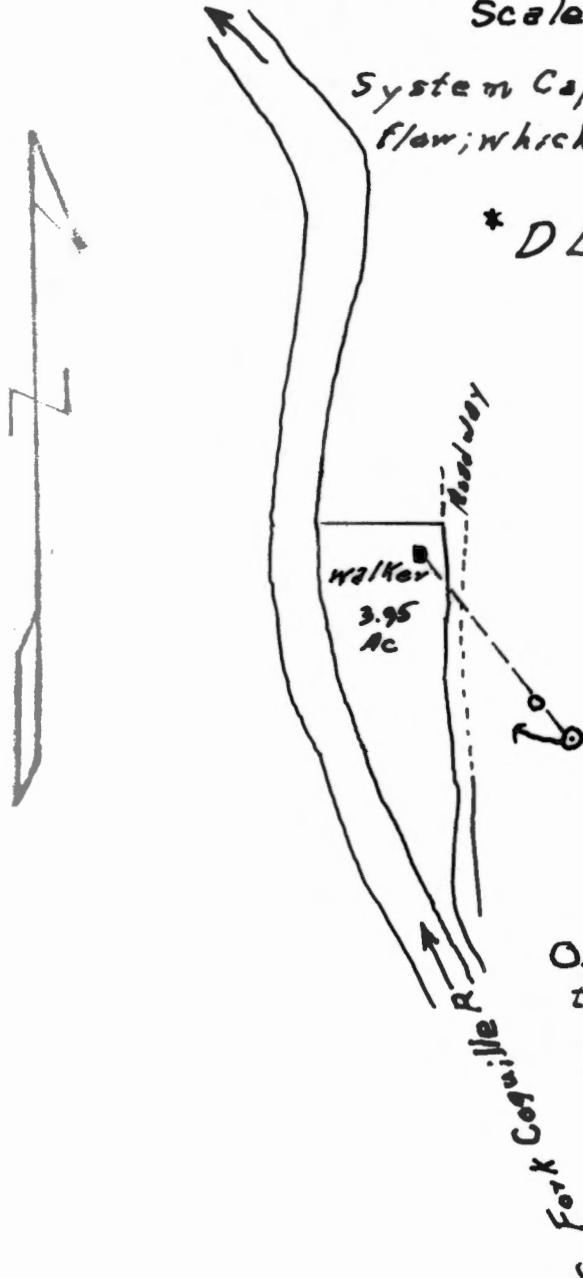

POD is 338 ft. N. and 1493 ft.
W. of SW. Cor. Sec 7, 31-11.

OAR 690-14-170-4 "the map is for
the purpose of identifying the location
of the water right only"

7

18