


T.3S. R.1E. Section 8, W.M.

RECEIVED

JUL 30 2020

CWRD

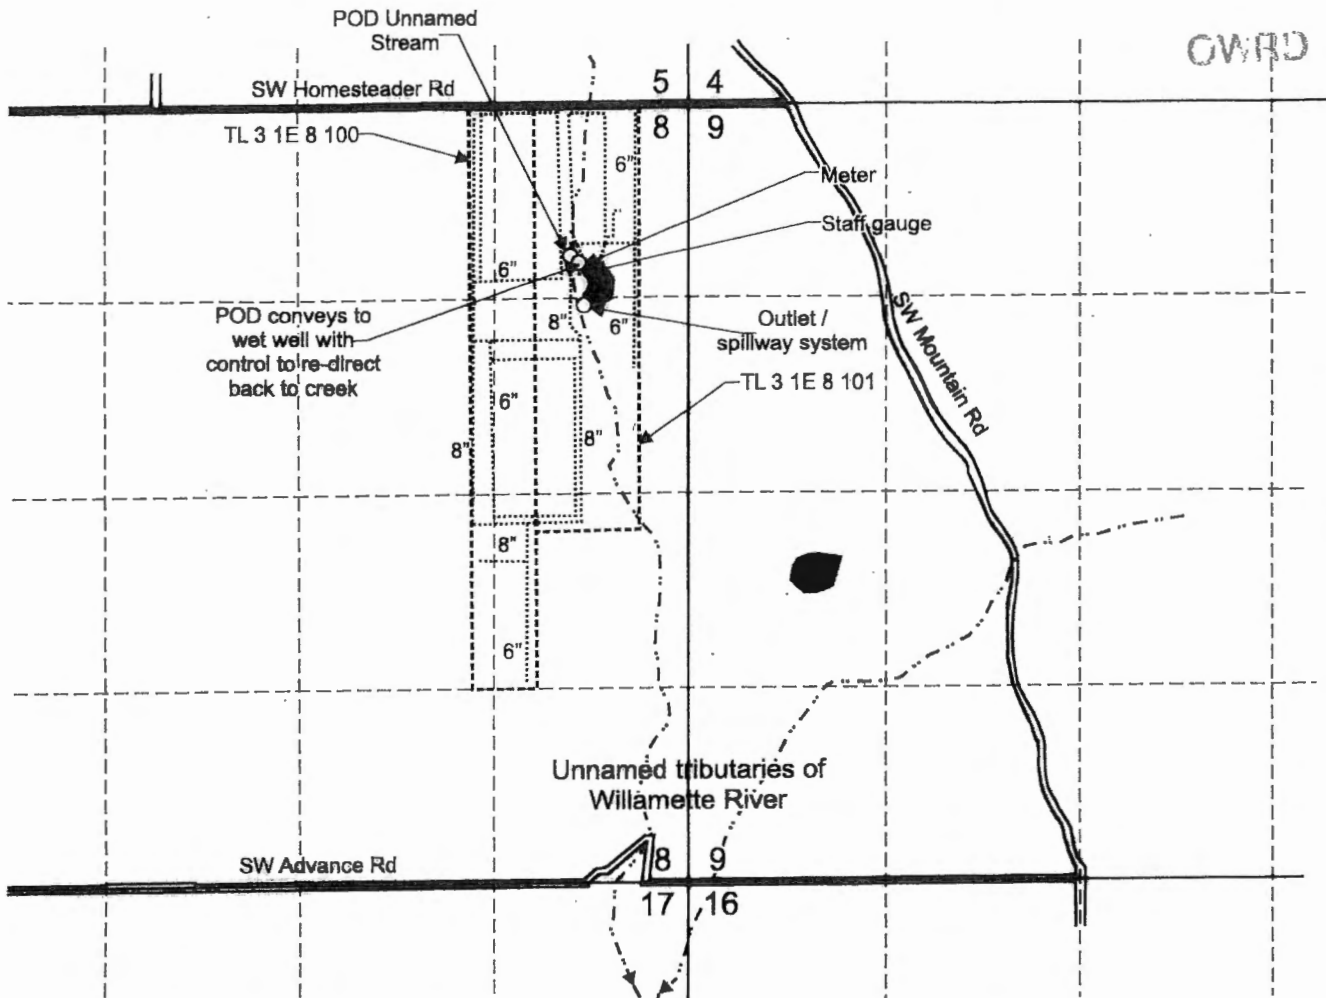

POD is located 1,010 feet south and 800 feet west from the NE corner, Section 8.

Outlet is located 1,370 feet south and 705 feet west from the NE corner, Section 8.

Reservoir (4.15 AF) submerged under Application R-86517, Permit R-14437.


----- Tax lot boundary

..... Water main line



RECEIVED June 30 2020

Scale: 1" = 1,320'

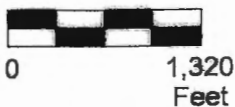

This map was prepared for the purpose of identifying the location of a water right only and is not intended to provide legal dimensions or location of property ownership lines.

Claim of Beneficial Use Map
Application R-86517, Permit R-14437

Pacific Hydro-Geology Inc.

07/2020

KAW Investments
T.3S. R.1E. Section 8, W.M.