


T.3S. R.1E. Section 8, W.M.

RECEIVED

JUL 30 2020

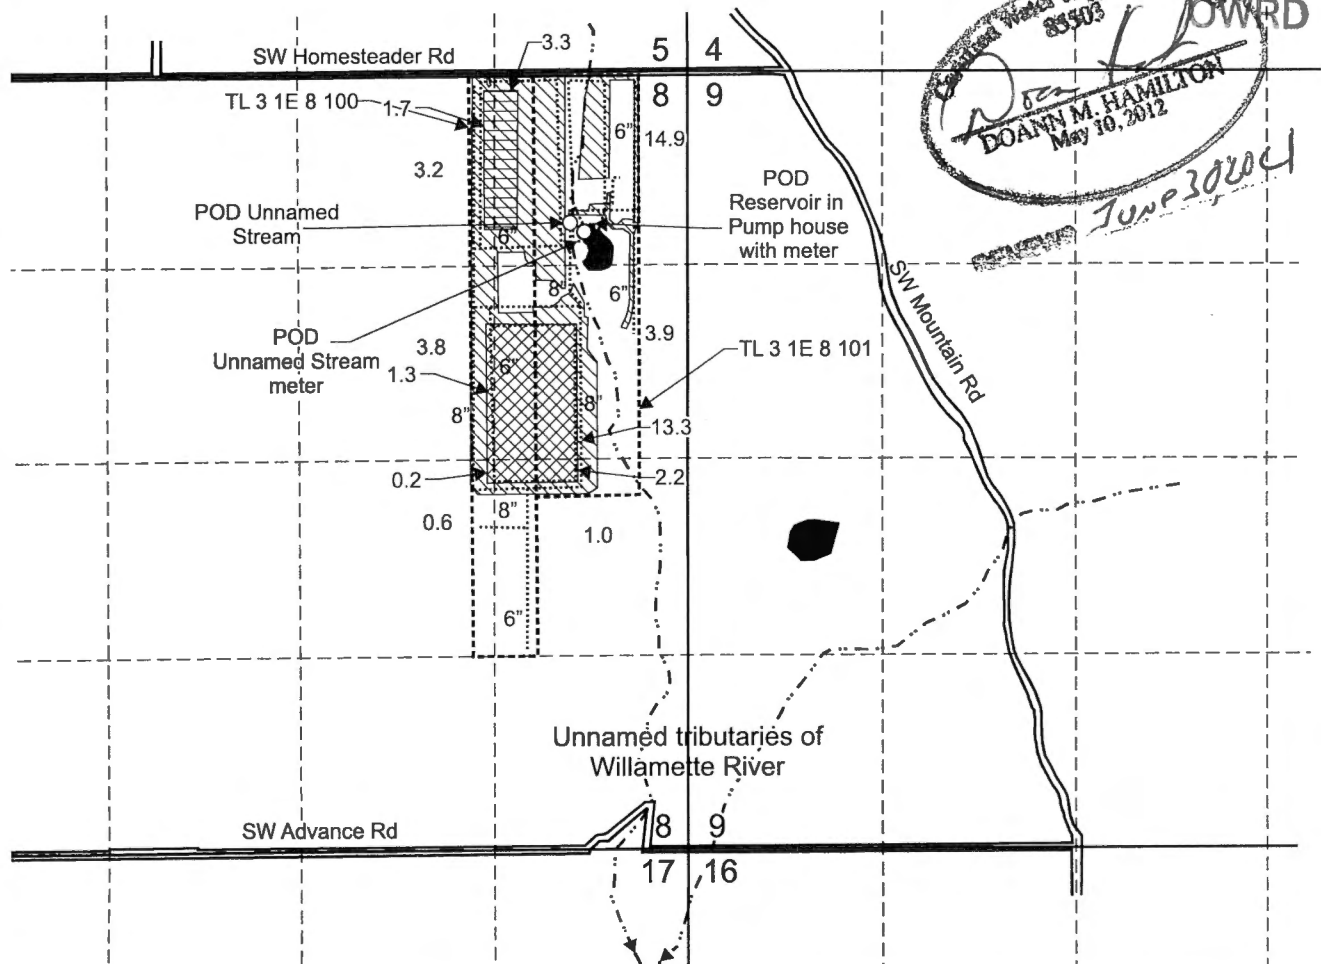


POD from Unnamed Stream is located 1,010 feet south and 800 feet west from the NE corner, Section 8.
POD from Reservoir is located 1,015 feet south and 635 feet west from the NE corner, Section 8.

-  Reservoir (4.15 AF) submerged under Application R-86517, Permit R-14437.
-  Area (27.4 acres) of primary irrigation under Application S-86518, Permit S-54401.
-  Area (5.0 acres) of supplemental irrigation under Application S-86518, Permit S-54401.
(Primarily irrigated under Certificate 82444.)
-  Area (17.0 acres) of supplemental irrigation under Application S-86518, Permit S-54401.
(Primarily irrigated under Certificate 88793.)

----- Tax lot boundary Water main line

Scale: 1" = 1,320'

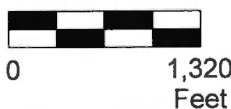

This map was prepared for the purpose of identifying the location of a water right only and is not intended to provide legal dimensions or location of property ownership lines.

Claim of Beneficial Use Map
Application S-86518, Permit S-54401

Pacific Hydro-Geology Inc.

07/2020

KAW Investments
T.3S. R.1E. Section 8, W.M.