


T.4S. R.1W. Section 11

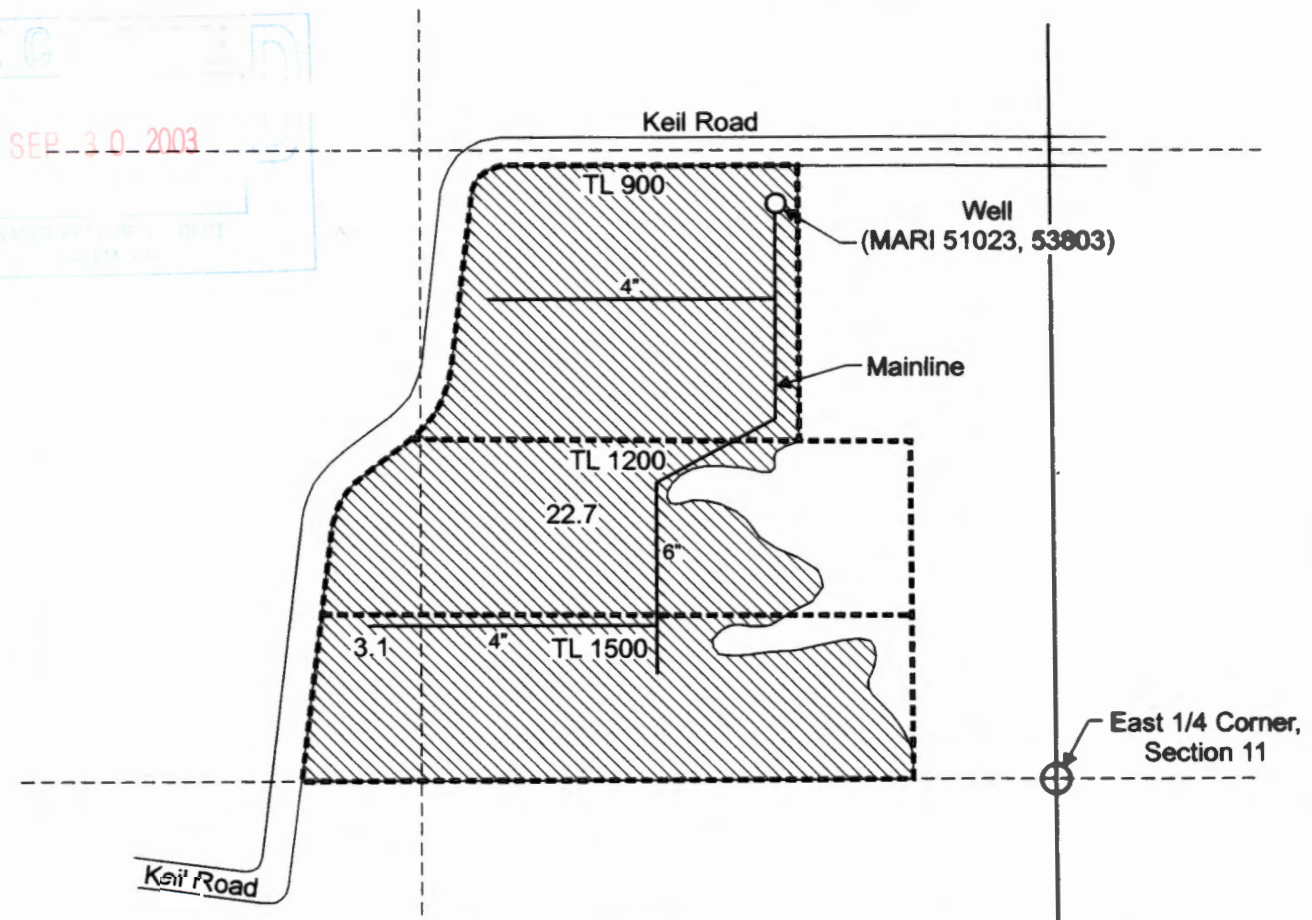

Well (MARI 53023, 53803) is located 1,210 feet north and 585 feet west from the east 1/4 corner of Section 11.


 Area (25.8 Acres) irrigated under Application G-14457, Permit G-13379.

----- Tax Lot Boundaries



EXPIRATION DATE 6/30/05

Scale: 1" = 400'

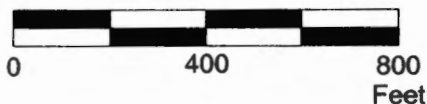

This map was prepared for the purpose of identifying the location of a water right only and is not intended to provide legal dimensions or location of property ownership lines.



Claim of Beneficial Use Map

Pacific Hydro-Geology Inc.

Oregon Flowers Inc.
T.4S. R.1W. Section 11A, Tax Lots 900, 1200 & 1500

9/28/03