

-32-33

-05-04

US HWY-20

T22S R32.5E W.M.

T23S R32.5E W.M.

T23S R32.5E, WM HARNEY COUNTY, OR



0 400 Feet

1" = 400'


- Well
- Meter
- Pipeline
- ▨ POU IR
- Section
- Quarter Quarter
- Tax Lot

Well (HARN 635) Location:
700' S, 800' E of NW Cor Sec 4

RECEIVED

JAN 07 2022

OWRD

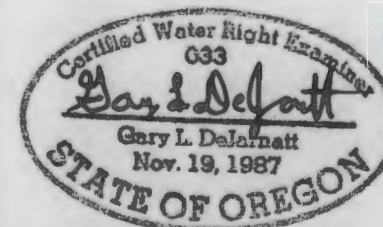

RENEWAL DATE 12/31/2021



CLAIM OF BENEFICIAL USE MAP Pickett

Date: 10/15/2021

Ap G-8880

Permit G-8430

This map is not intended
to provide legal dimensions
or locations of property
ownership lines.

Project #21042

WATER RIGHT SERVICES, LLC
PO BOX 1830, BEND, OR 97709
WWW.OREGONWATER.US CCB # 197121
johnshort@usa.com 541-389-2837