

RENEWAL DATE 12/31/2021



T9S R2W, WM MARION COUNTY, OR

- Well & Meter
- Pipeline
- POU NU
- DLC
- Section
- Quarter Quarter
- Tax Lot

RECEIVED

JUN 18 2021

OWRD

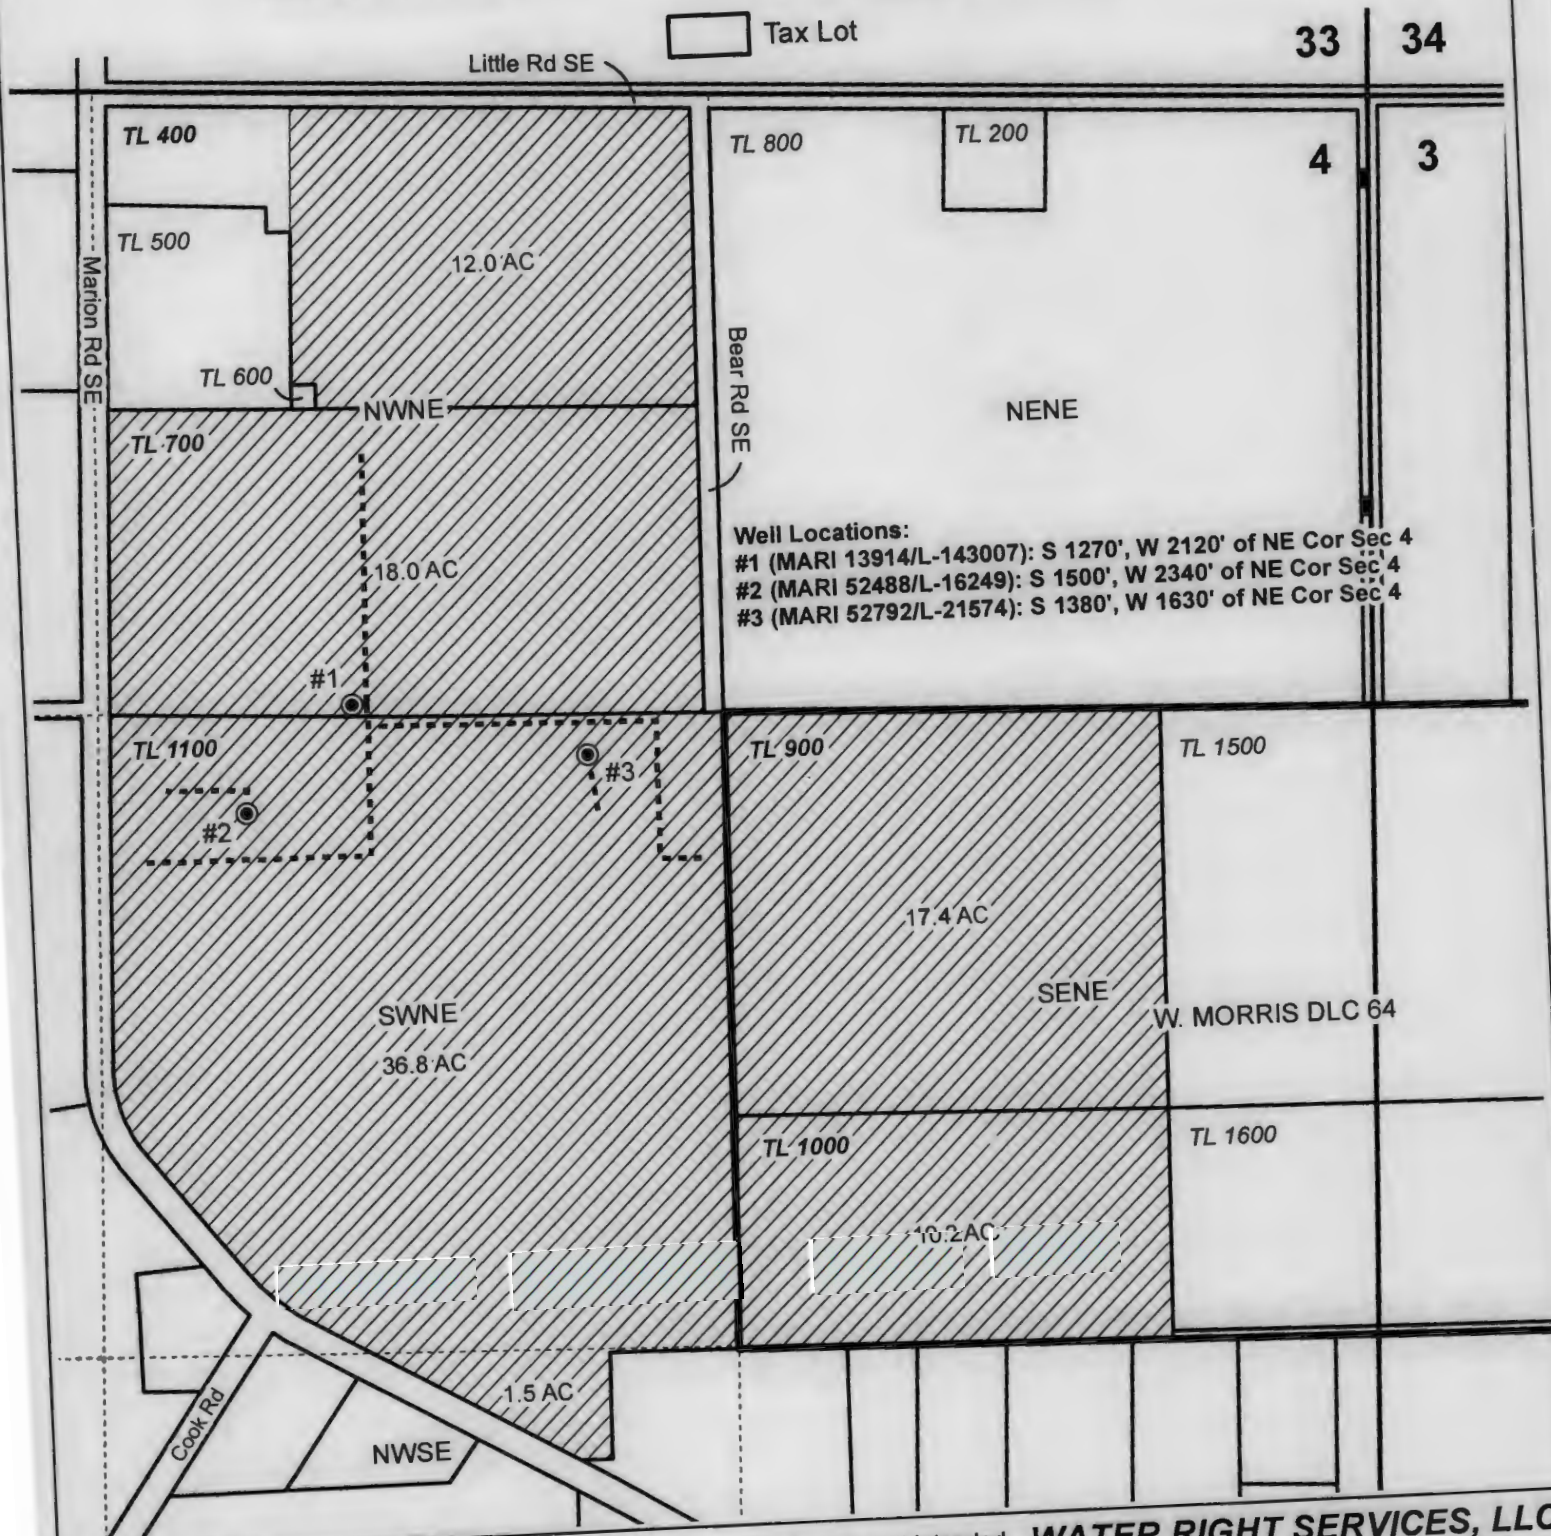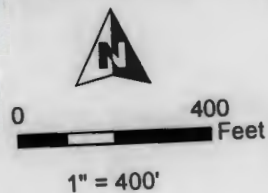

CLAIM OF BENEFICIAL USE MAP
 Jon Remy Jr. Project #20097

Date: 5/28/2021

Ap G-18858 Permit G-18495

This map is not intended
 to provide legal dimensions
 or locations of property
 ownership lines.

WATER RIGHT SERVICES, LLC
 PO BOX 1830, BEND, OR 97709
 WWW.OREGONWATER.US CCB # 197121
 johnshort@usa.com 541-389-2837