


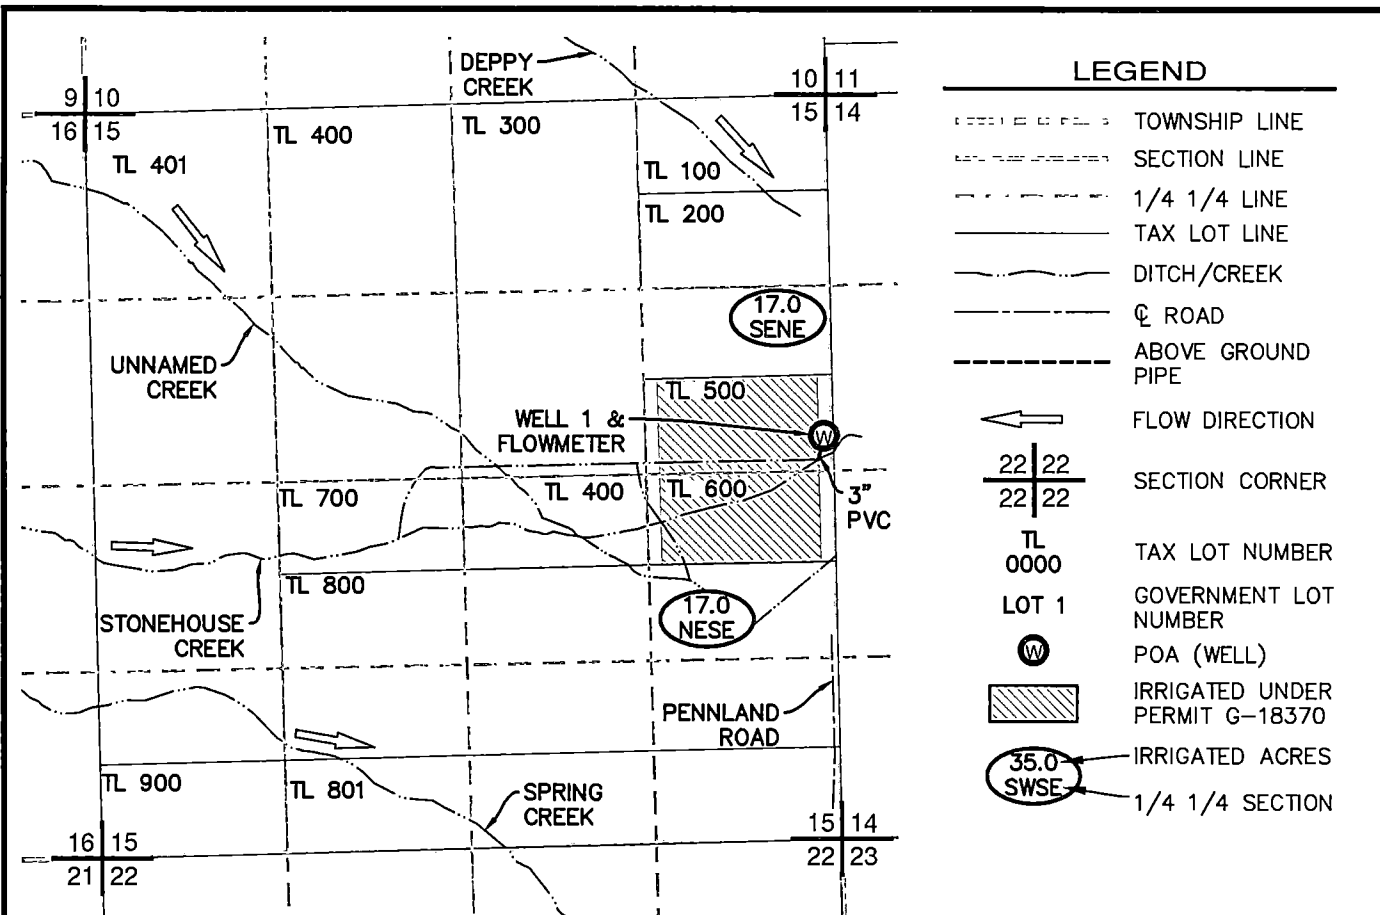

NOTES:

1. THIS MAP WAS PREPARED FROM FIELD MEASUREMENTS, NAIP 2020 AERIAL PHOTOGRAPHY, HARNEY COUNTY TAX MAPS, AND OREGON GLO MAPS.
2. THE PURPOSE OF THIS MAP IS TO IDENTIFY THE LOCATION OF THE WATER RIGHT ONLY, AND IS NOT INTENDED TO PROVIDE DIMENSIONS OR LOCATION OF PROPERTY LINES.
3. DATE OF PRIORITY FOR THIS WATER RIGHT IS JULY 31, 2008.



WELL LOCATION:

WELL 1: T35S, R33E, SECTION 15, W.M.; 240' NORTH & 2560' EAST FROM THE CENTER 1/4 CORNER OF SECTION 15.

RECEIVED

SEP 09 2021

OWRD

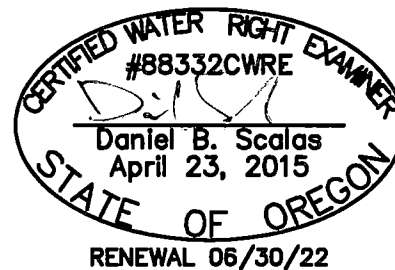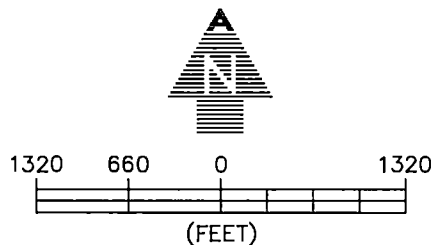

AL ADKINS
ENGINEERING & SURVEYING

o / 541.884.4666
w / AdkinsEngineering.com

1435 ESPLANADE AVENUE, KLAMATH FALLS, OR 97601

SERVING S. OREGON & N. CALIFORNIA

ENGINEERING • SURVEYING • PLANNING • TESTING

CLAIM OF BENEFICIAL USE AND FINAL PROOF MAP

FOR
GEORGE STROEMPLE
T35S, R33E, SEC. 15, WM
HARNEY COUNTY, OREGON
PERMIT G-18370
APPLICATION G-17089