





**HOOD RIVER COUNTY
SEC. 27 T02N R10E
SCALE - 1" = 400'**

RECEIVED
MAR 24 2022
OWRD



NW 1/4 OF THE NE 1/4

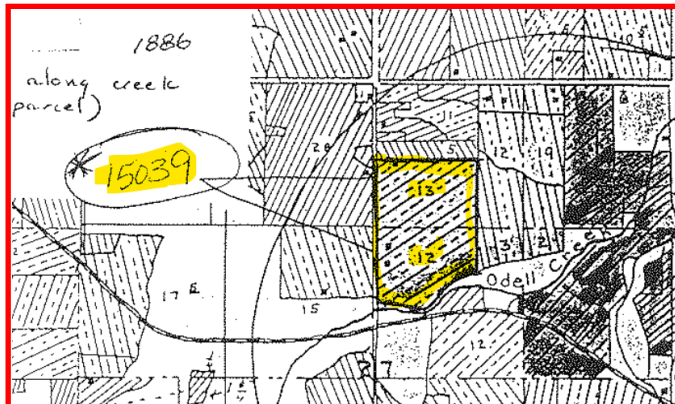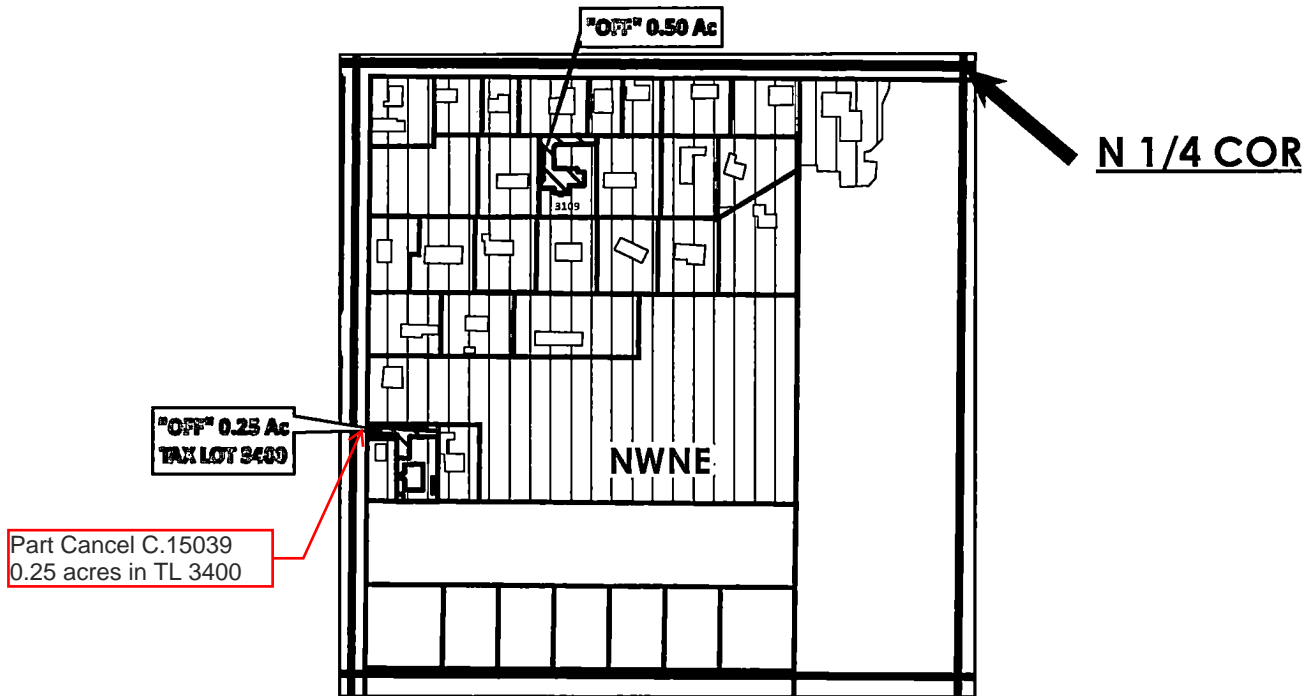

Cert 92000 20.75 Ac

 OFF LANDS - 92000
 EXISTING WATER RIGHTS

APPLICATION FOR PERMANENT WATER RIGHTS TRANSFER

FROM: CAROL S. KELLEY

TAX LOT: 3109 0.50 ACRE

FROM: TONI STUART, TRUSTEE

TAX LOT: 3400 0.25 ACRE

13957