

FINAL PROOF SURVEY MAP
 PERMIT G-15145
 THREEMILE CANYON FARMS
 TOWNSHIP 3 NORTH, RANGE 23 & 24 EAST, W.M.
 MORROW COUNTY


- LEGEND**
- ★ Filter Assembly
 - Flow Meter
 - Distribution System
 - - - Drain Tile
 - ☐ Tax Lot
 - ☐ Section
 - - - Quarter-Quarter
 - Place of Use

POA AND FLOW METER LOCATION DESCRIPTIONS:

DRAIN TILE 2
 SE 1/4 NE 1/4, SECTION 9, T3N, R23E, W.M. 1964 FEET SOUTH AND 779 FEET WEST FROM THE NORTHEAST CORNER SECTION 9.

DRAIN TILE 3
 NE 1/4 SE 1/4, SECTION 6, T3N, R24E W.M. 2198 FEET NORTH AND 666 FEET WEST FROM THE SOUTHEAST CORNER OF SECTION 6.

COBU MAP #2016 (Folder A-5)
 Certified Water Rights Examiner Stamp

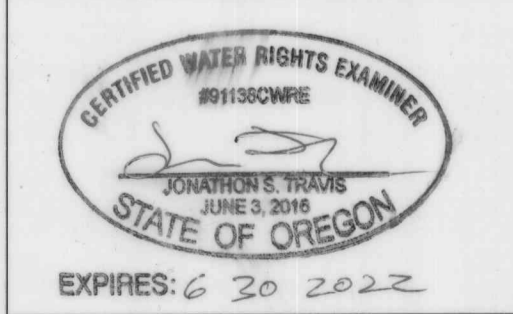


NOTE: THE PURPOSE OF THIS MAP IS TO IDENTIFY THE LOCATION OF THE WATER RIGHT. IT IS NOT INTENDED TO PROVIDE INFORMATION RELATED TO THE LOCATION OF PROPERTY OWNERSHIP BOUNDARY LINES

Scale: 1:15,840 (1 in = ft)

0 1000 2000 3000 Feet

Map Date: 5/8/2021 11:24 AM

Drawn By: Will Anderson | www.anderson-geographics.com
 Data: Anderson Geographics LLC, State of Oregon, Threemile Canyon Farms

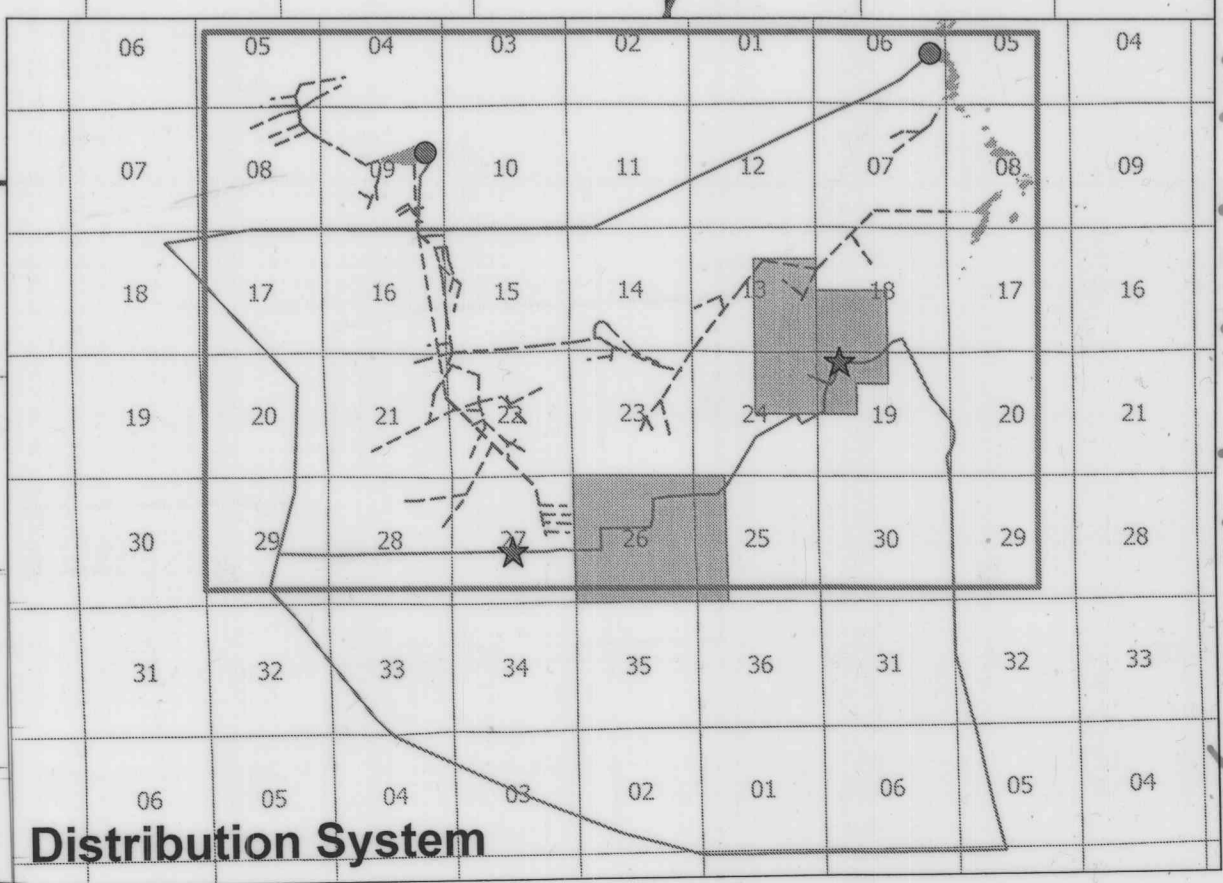

COBU MAP #2016 (Folder A-5)

RECEIVED
 MAR 28 2022
 OWRD