


11996

CLAIM OF BENEFICIAL USE FOR TRANSFER OF PLACE OF USE ONLY

TRANSFER: T-8724
LOCATED IN THE W 1/2 SW 1/4 SECTION 29, AND IN
SECTION 30 AND IN THE N 1/2 OF SECTION 31 AND IN
THE N 1/2 NW 1/4 OF SECTION 32, TOWNSHIP 17
SOUTH, RANGE 15 EAST, W.M.,
CROOK COUNTY, OREGON

RECEIVED
NOV 01 2019
OWRD

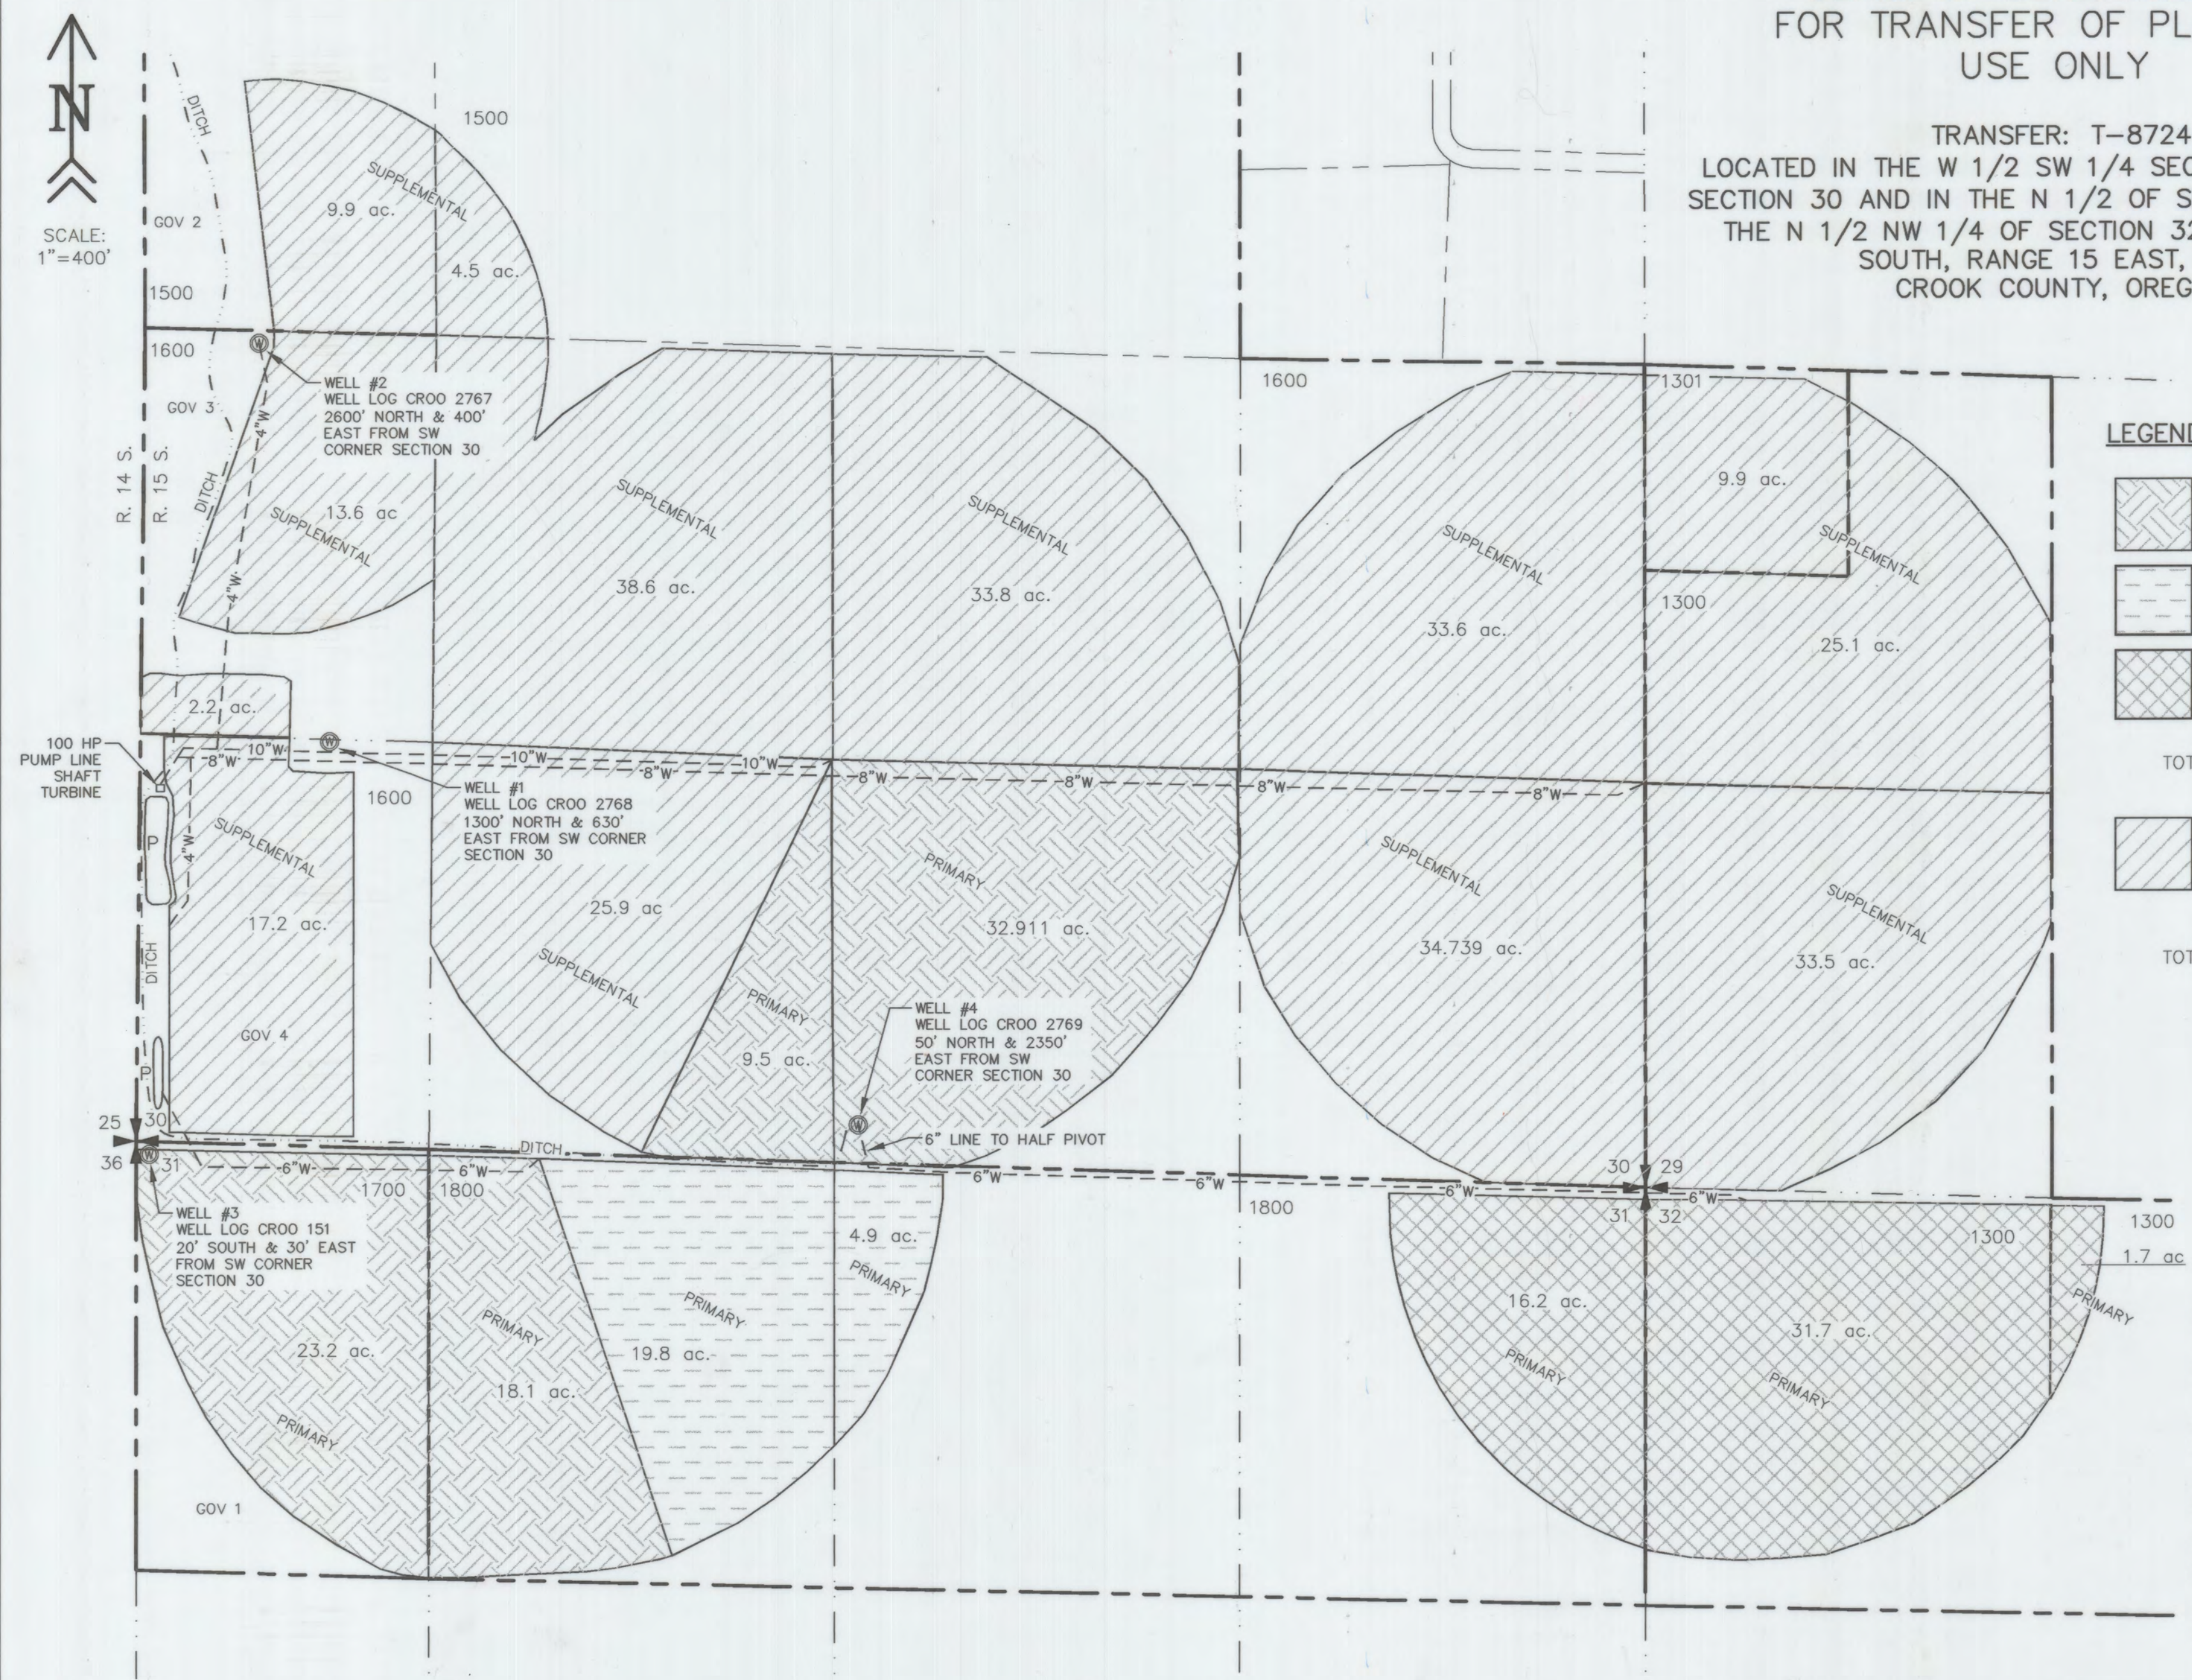


LEGEND:

- 83.711 AC PRIMARY FROM WELLS #1 AND #2
- 24.70 AC PRIMARY FROM WELL #3
- 49.60 AC PRIMARY FROM WELL #4

TOTAL - 158.011 AC PRIMARY

282.539 AC SUPPLEMENTAL FROM WELLS 1 & 2, UNDERLYING PRIMARY IRRIGATION WATER IS FROM CENTRAL OREGON IRRIGATION DISTRICT

TOTAL - 283.039 AC SUPPLEMENTAL

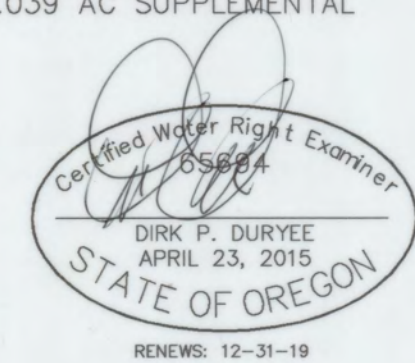

WELL LOCATIONS:

WELL # 1 IS LOCATED 1300 FEET NORTH AND 630 FEET EAST OF THE SW CORNER OF SECTION 30.
WELL # 2 IS LOCATED 2600 FEET NORTH AND 400 FEET EAST OF THE SW CORNER OF SECTION 30
WELL # 3 IS LOCATED 20 FEET SOUTH AND 30 FEET EAST OF THE SW CORNER OF SECTION 30
WELL # 4 IS LOCATED 50 FEET NORTH AND 2350 FEET EAST OF THE SW CORNER OF SECTION 30
NOTE: METERS WERE INSTALLED AT EACH WELL SITE BUT ARE NO LONGER WORKING

DISCLAIMER: "THIS MAP IS NOT
INTENDED TO PROVIDE LEGAL
DIMENSIONS OR LOCATIONS OF
PROPERTY OWNERSHIP LINES"

TITLE: CLAIM OF BENEFICIAL USE		
JOB NO: 2355 - WAYNE & SUSAN SINGHOSE		
SCALE: 1"=400'	BY: P.A.T.	
	DATE: 10-11-19	
2355_final proof.dwg	SHEET: 1 OF 1	
		725 NW HILL, BEND, OR 97703 541-389-6959