






This map is not intended to provide legal dimensions or locations of property ownership lines.

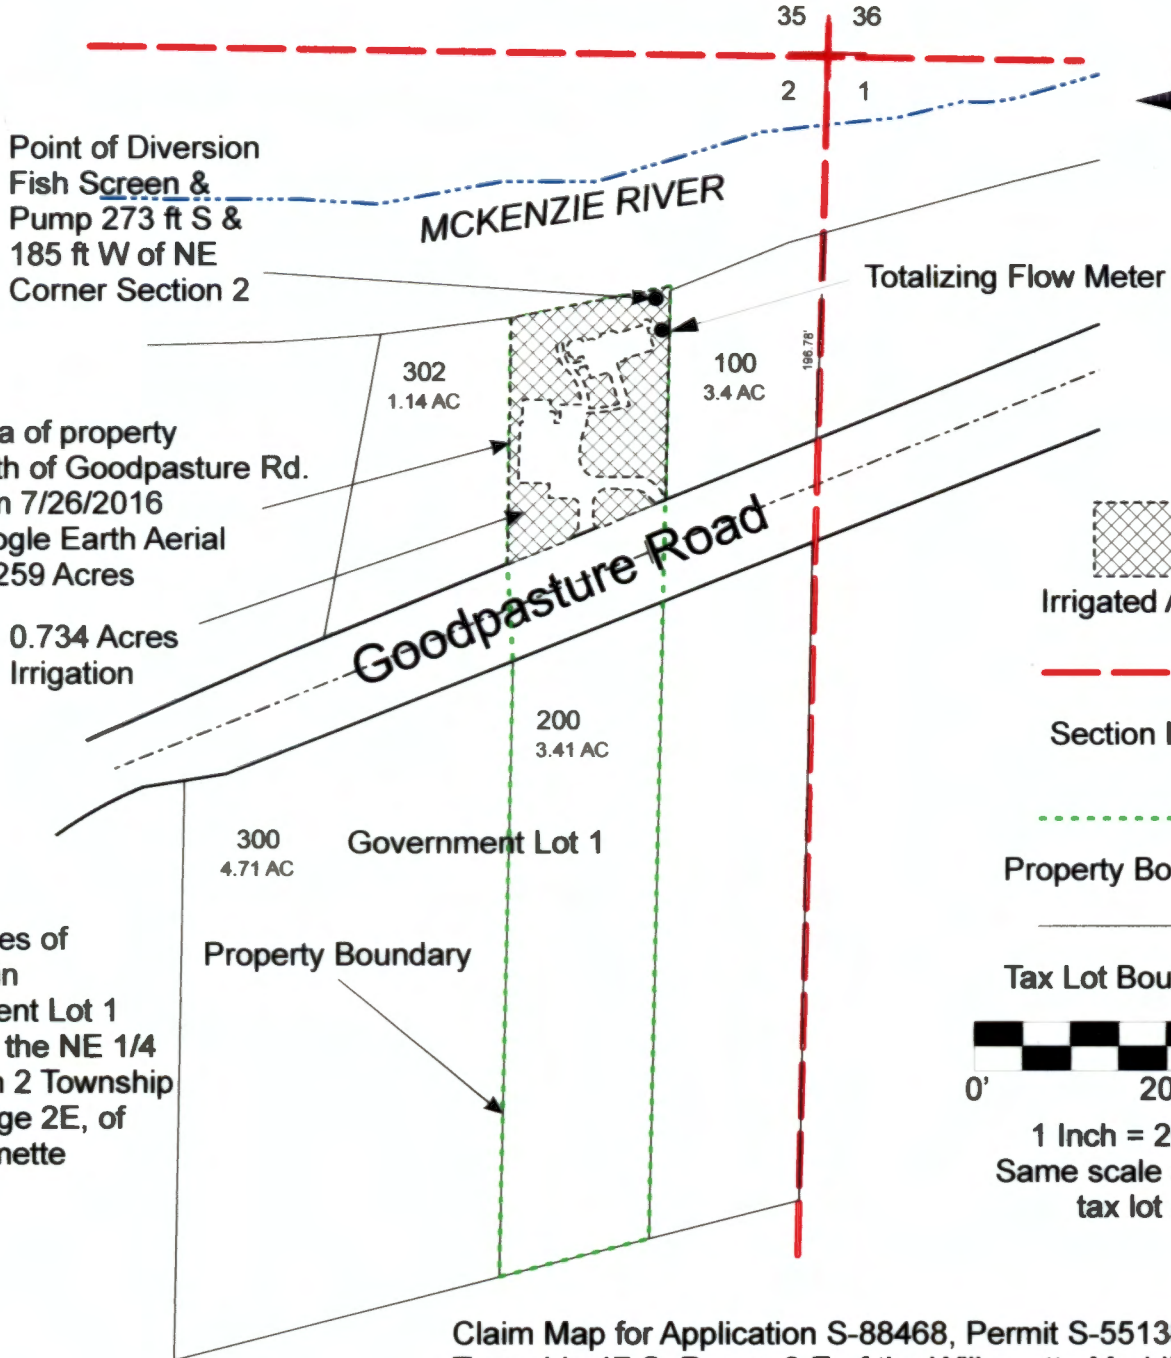


-  Irrigated Area
-  Section Line
-  Property Boundary
-  Tax Lot Boundaries

0' 200' 400'
 1 Inch = 200 Feet
 Same scale as County tax lot map

0.734 Acres of irrigation in Government Lot 1 NE 1/4 of the NE 1/4 of Section 2 Township 17S, Range 2E, of the Willamette Meridian

Claim Map for Application S-88468, Permit S-55138, Section 2, Township 17 S, Range 2 E of the Willamette Meridian Lane County Tax Lot 17-25-02-10-00200

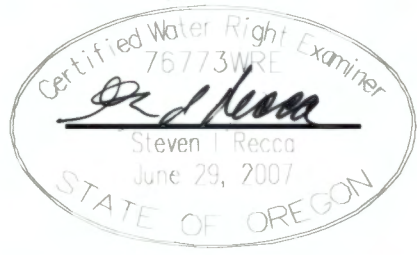

EXPIRATION DATE: 12/31/20

RECEIVED
 SEP 02 2020
 OWRD