


Claim of Beneficial Use

Application G-16882, Permit G-16872

LaFollette

Township 10S, Range 2W, W.M.

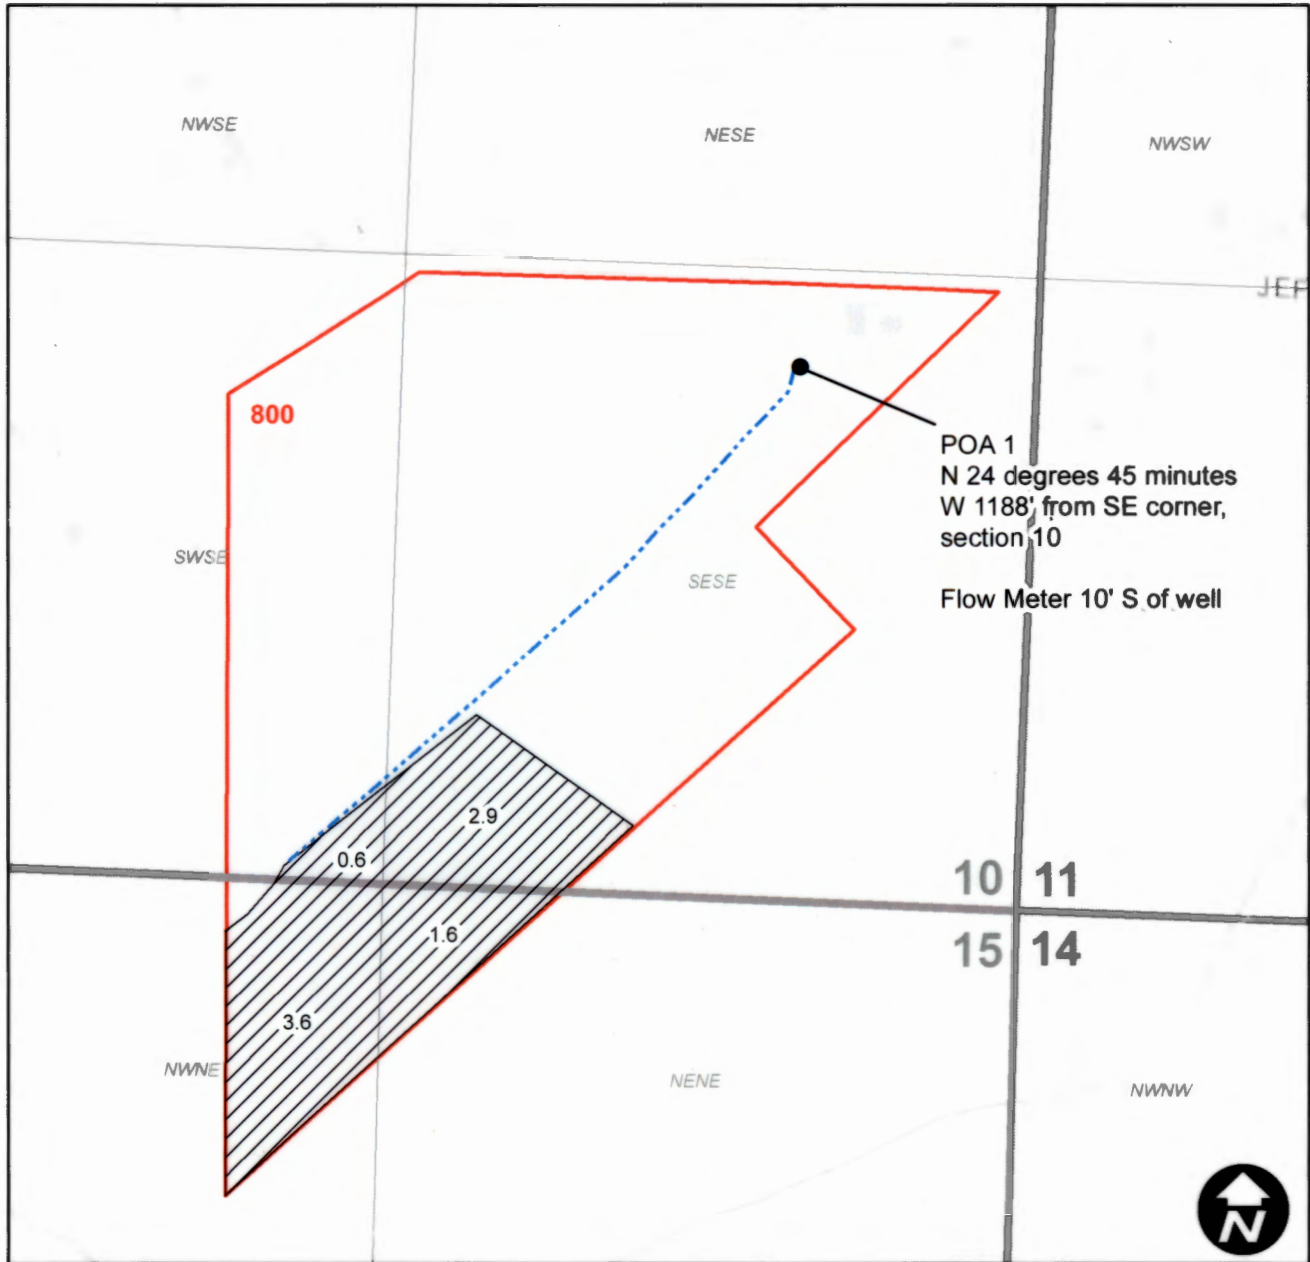

This map is not intended to provide legal dimensions or locations of property ownership lines.

0 200 400 800 Feet

Legend

-  POU
-  Mainline
-  Taxlot



EXPIRES: 12/31/2022