


FINAL PROOF SURVEY  
UNDER  
TRANSFER 11972  
SPECIAL ORDER 187-591

IN NAMES OF  
RAPHAEL & SANDRA DAVIS  
HAROLD & DIXIE REYNOLDS  
ROBERT TROY COX & STACY L. ROBINSON COX

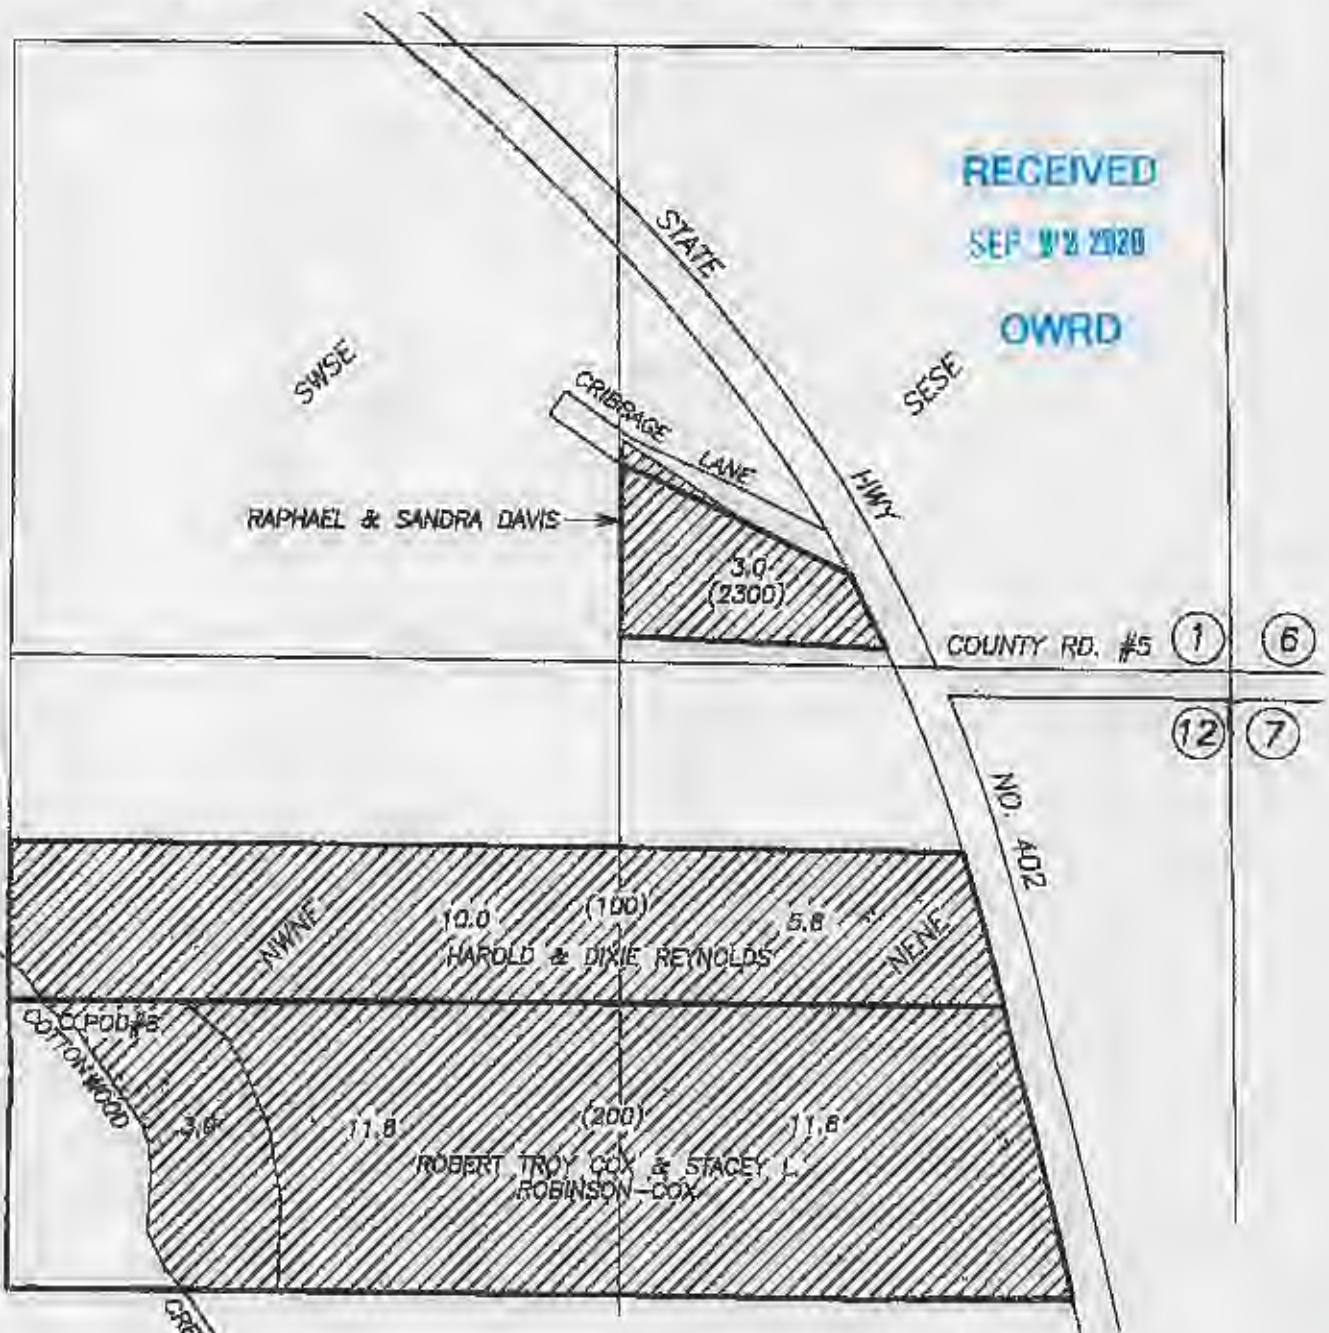


RECEIVED  
SEP 22 2020  
OWRD

SCALE: 1"=400'

T.9S., R.28E.

- **RAPHAEL & SANDRA DAVIS**  
POD #3: 3830' SOUTH & 1280' WEST FROM  
N1/4 COR. SEC. 18, T.9S., R.28E.  
MEASURING DEVICE & FISH SCREEN STRUCTURE  
BEARS N69E., 840 FT
- **HAROLD & DIXIE REYNOLDS**  
**ROBERT TROY COX & STACY ROBINSON-COX**  
POD #1: 4616' NORTH & 2770' EAST FROM  
SW COR. SEC. 12, MEASURING DEVICE AND FISH  
SCREEN STRUCTURE BEARS N19°W, 106 FT
- ( ) TAX LOT

PREPARED BY  
ROBERT D. BAGETT, PLS, CWRE  
217 N. CANYON BLVD.  
JOHN DAY, OR 97840  
AUGUST 28, 2020

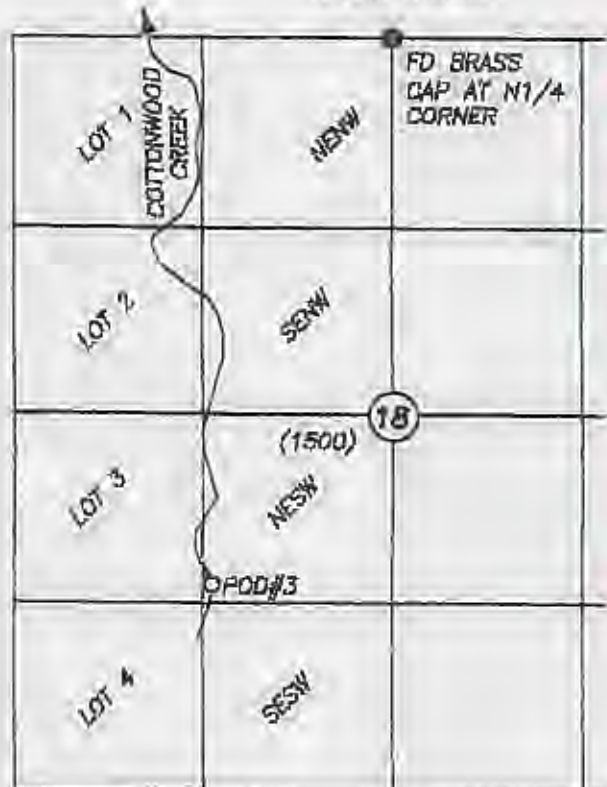

SCALE: 1"=1320'

DISCLAIMER: THIS MAP IS NOT INTENDED TO PROVIDE LEGAL DIMENSIONS OR LOCATIONS OF PROPERTY OWNERSHIP LINES.

COPY MAP # 1256