


RECEIVED

SEP 23 2019

T.3S. R.3W. Sec. 4 & 5, W.M.

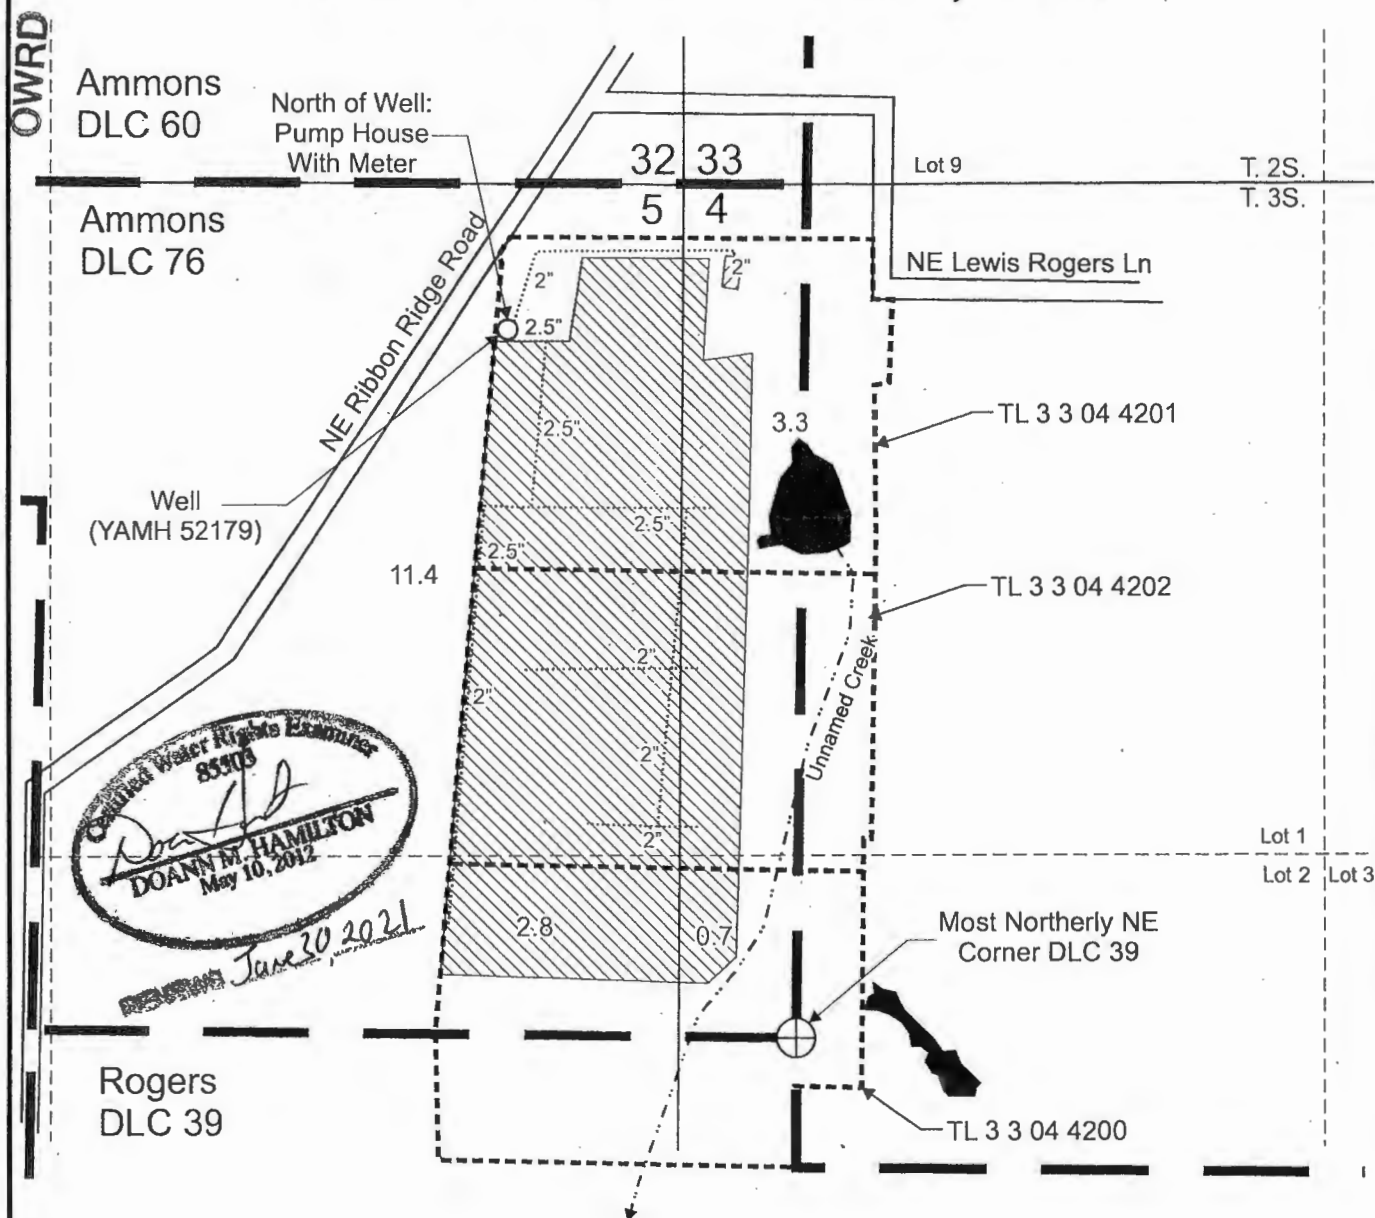


Well (YAMH 52179) is located 1,460 feet north and 590 feet west from the most northerly NE corner DLC 39.

Area (18.2 Acres) irrigated under Application G-15269, Permit G-17810.

Commercial Use Area under Application G-15269, Permit G-17810.

----- Tax lot boundary ————— Donation Land Claim boundary Irrigation main line

Scale: 1" = 400'

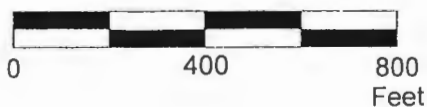

This map was prepared for the purpose of identifying the location of a water right only and is not intended to provide legal dimensions or location of property ownership lines.

Claim of Beneficial Use Map
Application G-15269, Permit G-17810

John Edward Looney
T.3S. R.3W. Sec. 4 & 5, W.M.

Pacific Hydro-Geology Inc.

08/2019

LooneyCOBUMap.cdr