




RECEIVED  
JUN 08 2023  
OWRD

### LEGEND

- Irrigated Area (Permit G-15654)
- Well (L-61811)
- 1.5 inch Mainline
- Reference Corner
- Baker County Taxlot Boundary [900]

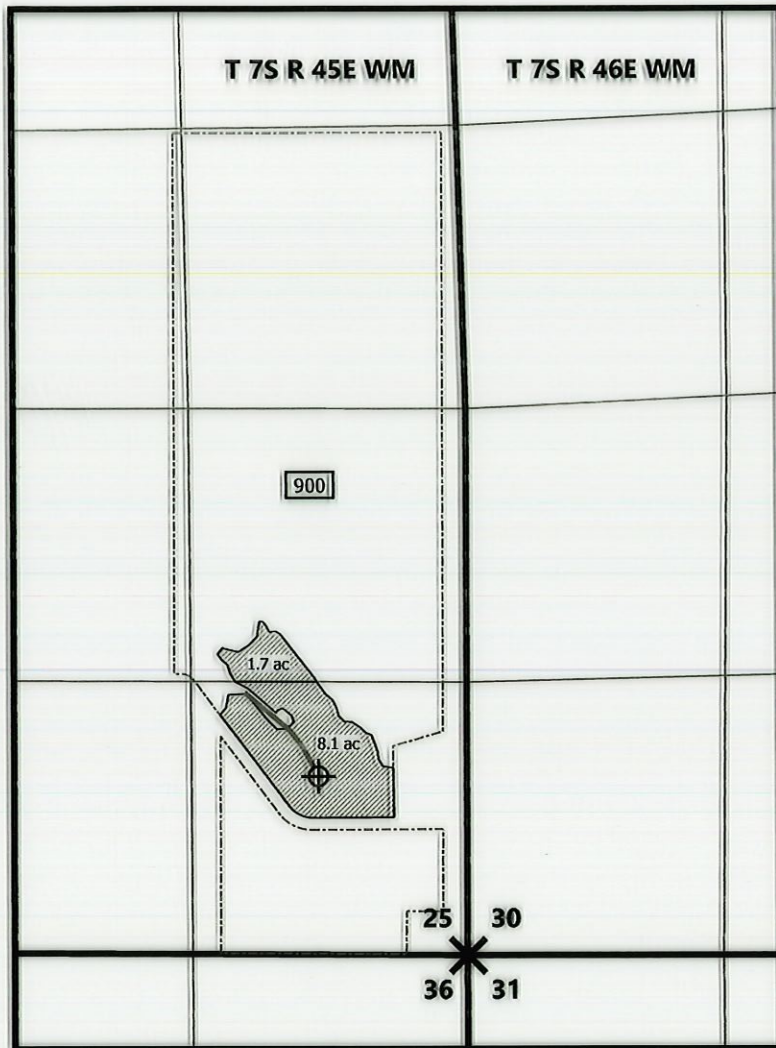

### Claim of Beneficial Use Map Application G-16086, Permit G-15654

Prepared on behalf of Brook and Lois Moore

1 inch = 1,320 feet



Reference Corner Located at the SE 1/4 of Section 25, Township 7 South, Range 45E, WM

Baker County Tax Lot 900

Well located 724 feet west and 857 feet north of the reference corner.

Well coordinates: Lat: 44.9229, Long: -117.1469

This map is not intended to provide legal dimensions or locations of property ownership lines.

Date: 6/5/2023  
Drawn by: Paul F. Garvin

Drawn by: Paul F. Garvin, R.G. C.W.R.E.  
Date: 9/5/19