

TOWNSHIP 14 SOUTH RANGE 39 EAST W.M.


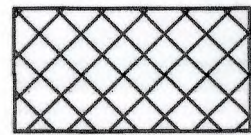
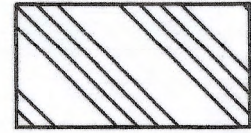




APPLICATION NO. G-17577
 PERMIT NO. G-17110


FINAL PROOF SURVEY
 FOR
NZ RANCHES LLC

Situated in Sections 21 and 22, Township 14 South, Range 39 East
 of the Willamette Meridian, Malheur County, Oregon
 Tax Lot 3701 Map 14S39E

SCALE: 1"=400'

LEGEND

-  Primary Right under Certificate 50392 - Supplemental Right under Certificate 32331
 -Portion of right not affected by this certificate
-  PRIMARY IRRIGATION RIGHT
-  SUPPLEMENTAL IRRIGATION RIGHT
-  Acreage pertaining to this certificate
-  Acreage of unaffected portion of 50392
-  Buried Mainline (size and type as described)
-  Well

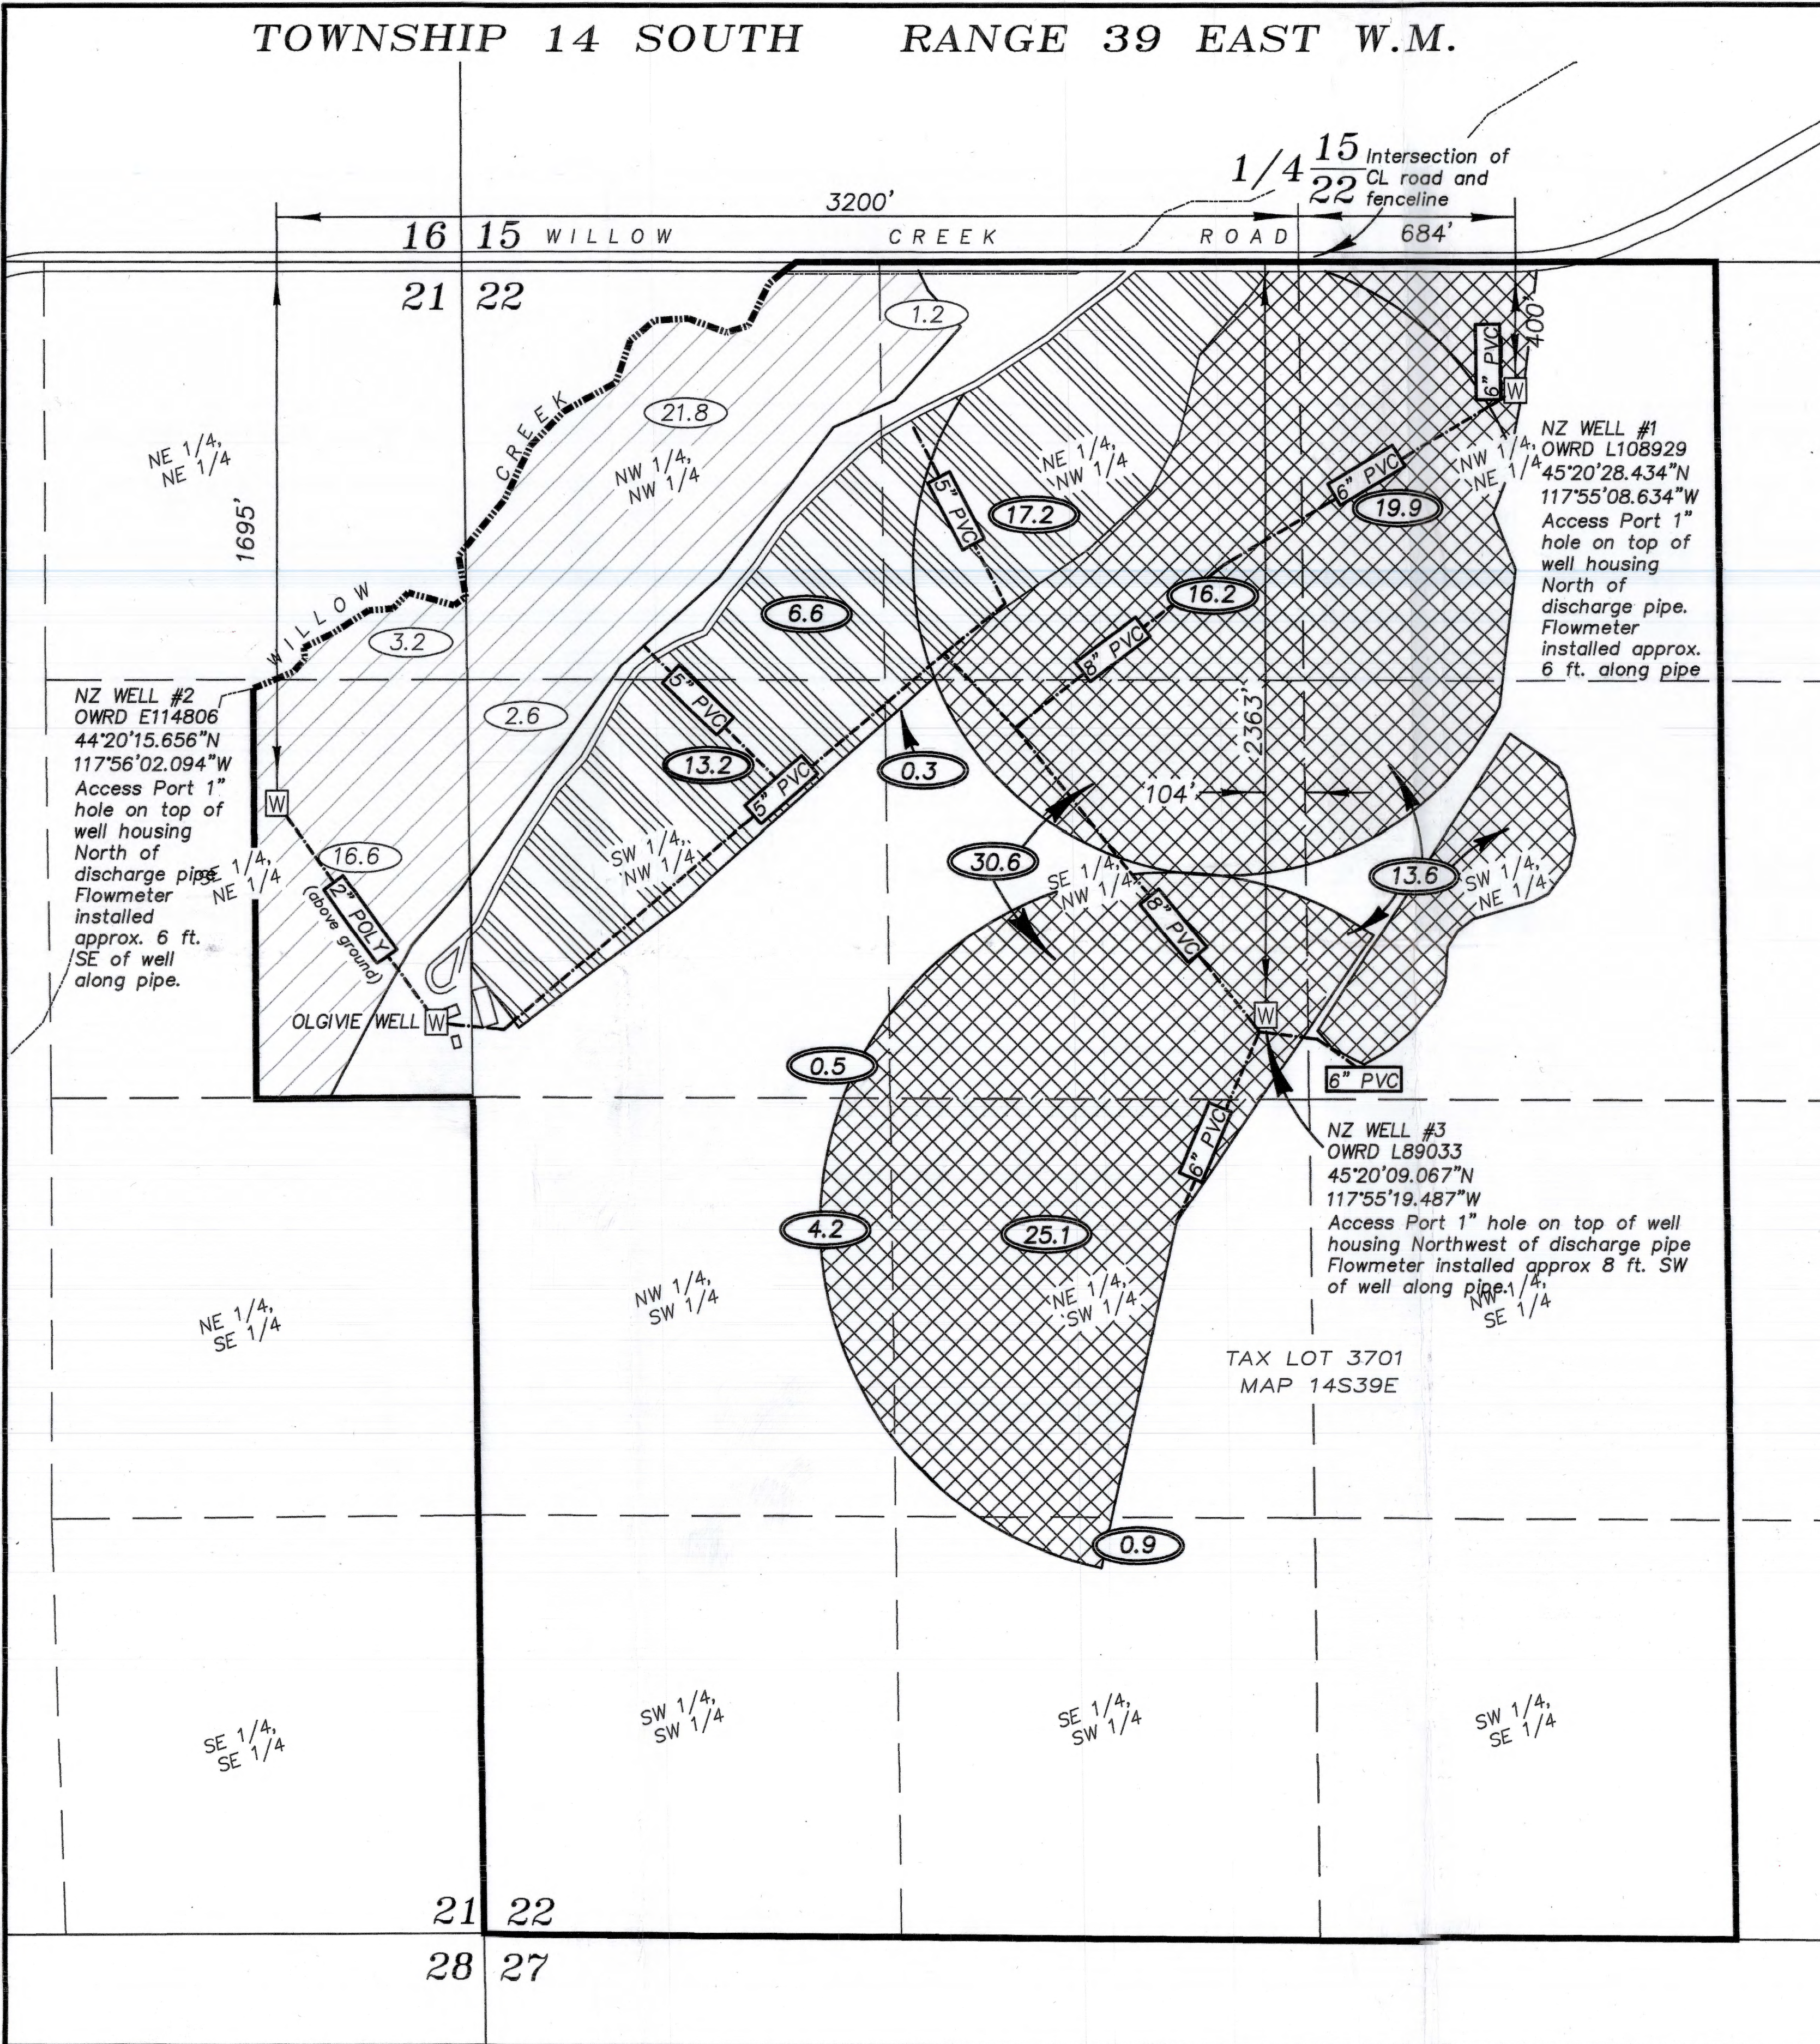

Renews: June 30,
 NOTE: The preparation of this map was for the purpose of identifying the location of the water right and has no intent to provide dimensions of locations of property ownership lines.

RECEIVED
 FEB 06 2020
 OWRD