


185-1W-33 NWNW 304

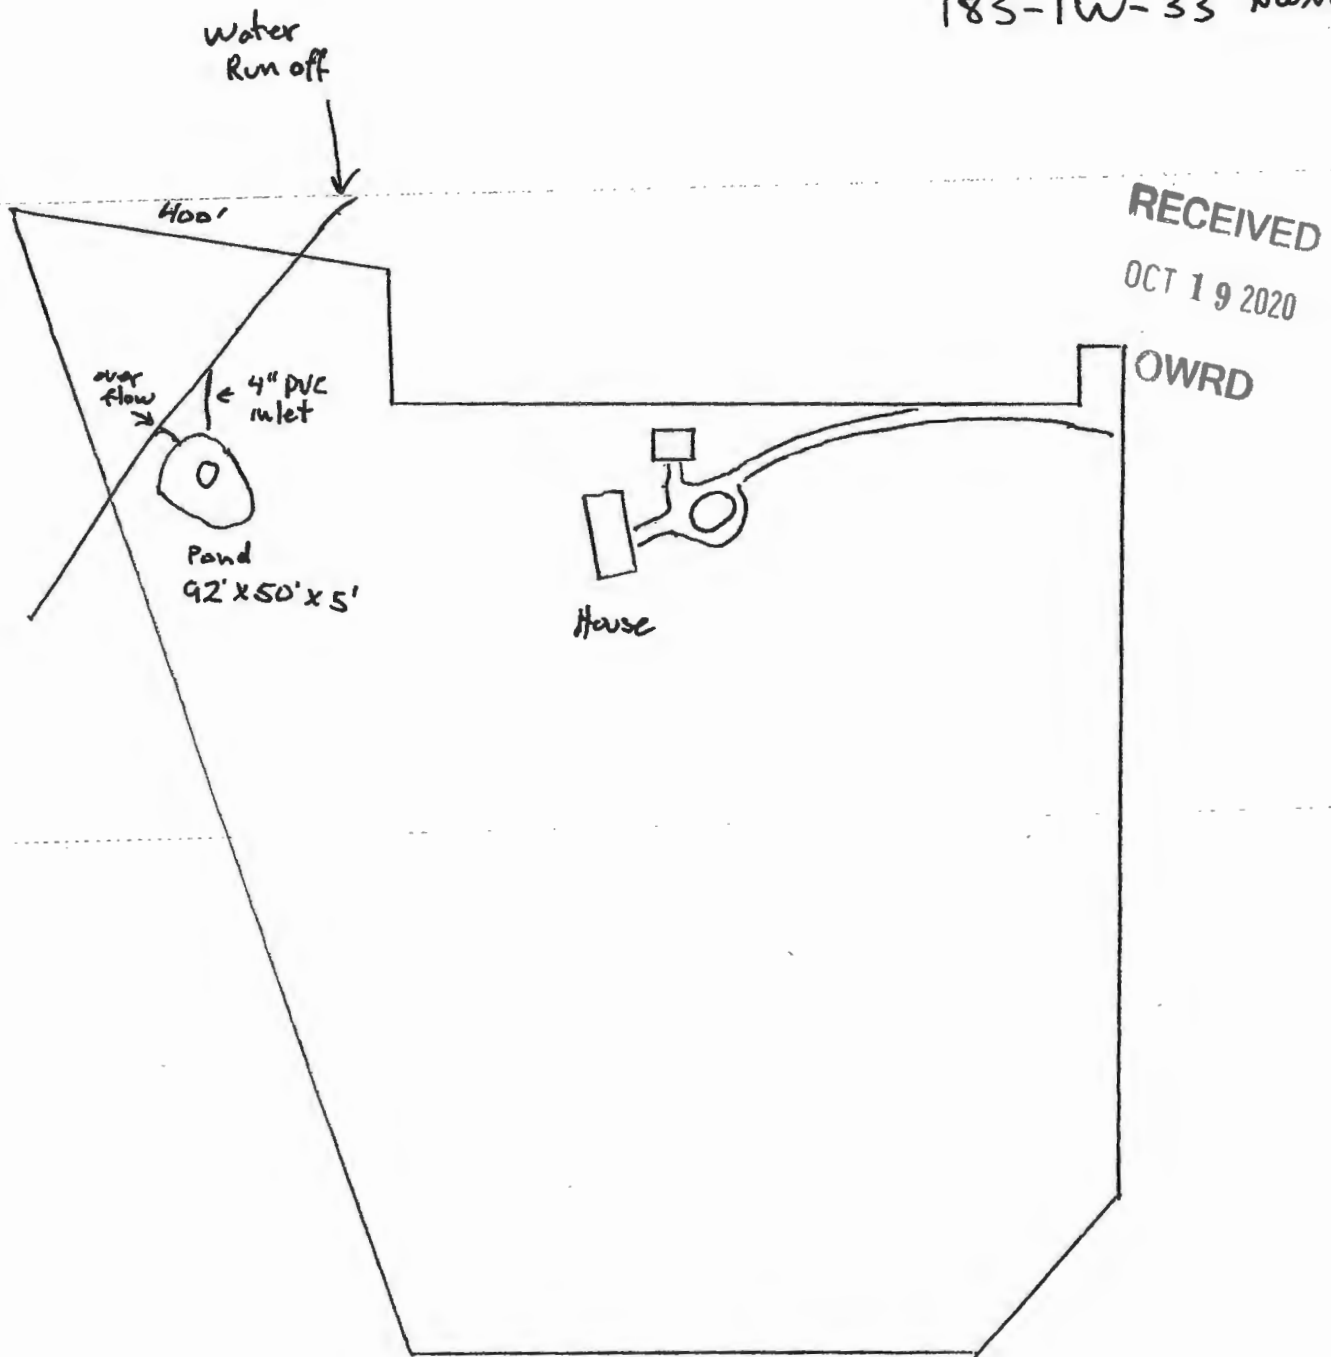

North

Timothy McMahon
38885 Jasper Lowell Rd
Fall Creek Or 97438

RECEIVED
MAY 31 2019
OWRD

1" = 200'