


**T10S R22E, WM
WHEELER COUNTY, OR**



0 1,320 Feet
1" = 1,320'

-  Borgwardt Reservoir - Multiple Purpose Use
-  Section
-  Quarter Quarter
-  Tax Lot

Center of Dam Location:
1120' S, 1050' E of the Center Cor Sec 22

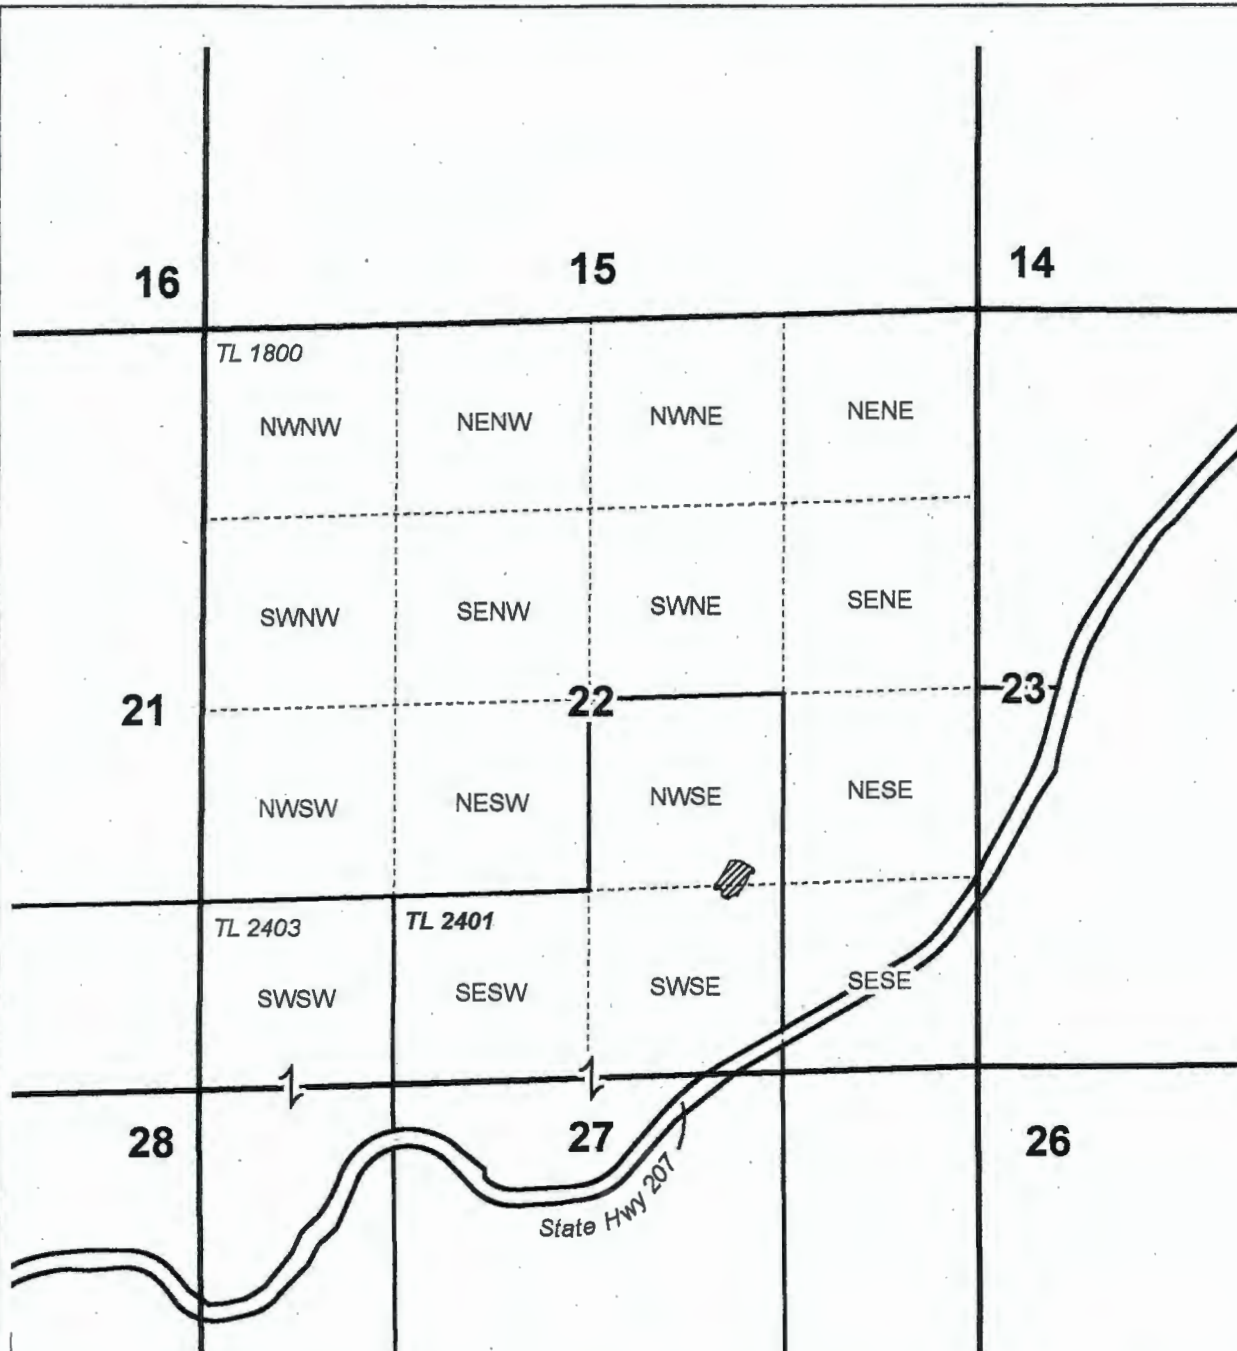

RECEIVED

OCT 26 2020

OWRD



**CLAIM OF BENEFICIAL USE MAP
BORGWARDT RANCH**

Date: 10/1/2020

AP R-87160 Permit R-14629

This map is not intended
to provide legal dimensions
or locations of property
ownership lines.

WATER RIGHT SERVICES, LLC
PO BOX 1830, BEND, OR 97709
WWW.OREGONWATER.US CCB # 197121
johnshort@usa.com 541-389-2837