

**T26S R33E, WM,
HARNEY COUNTY, OR**



0 1,320
Feet

1" = 1,320'

● Well & Meter



POU IR

Township

Section

--- Quarter Quarter

Tax Lot

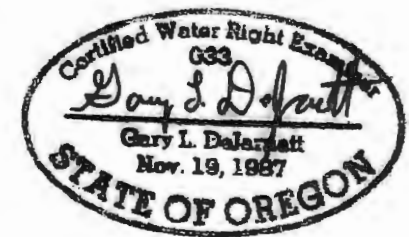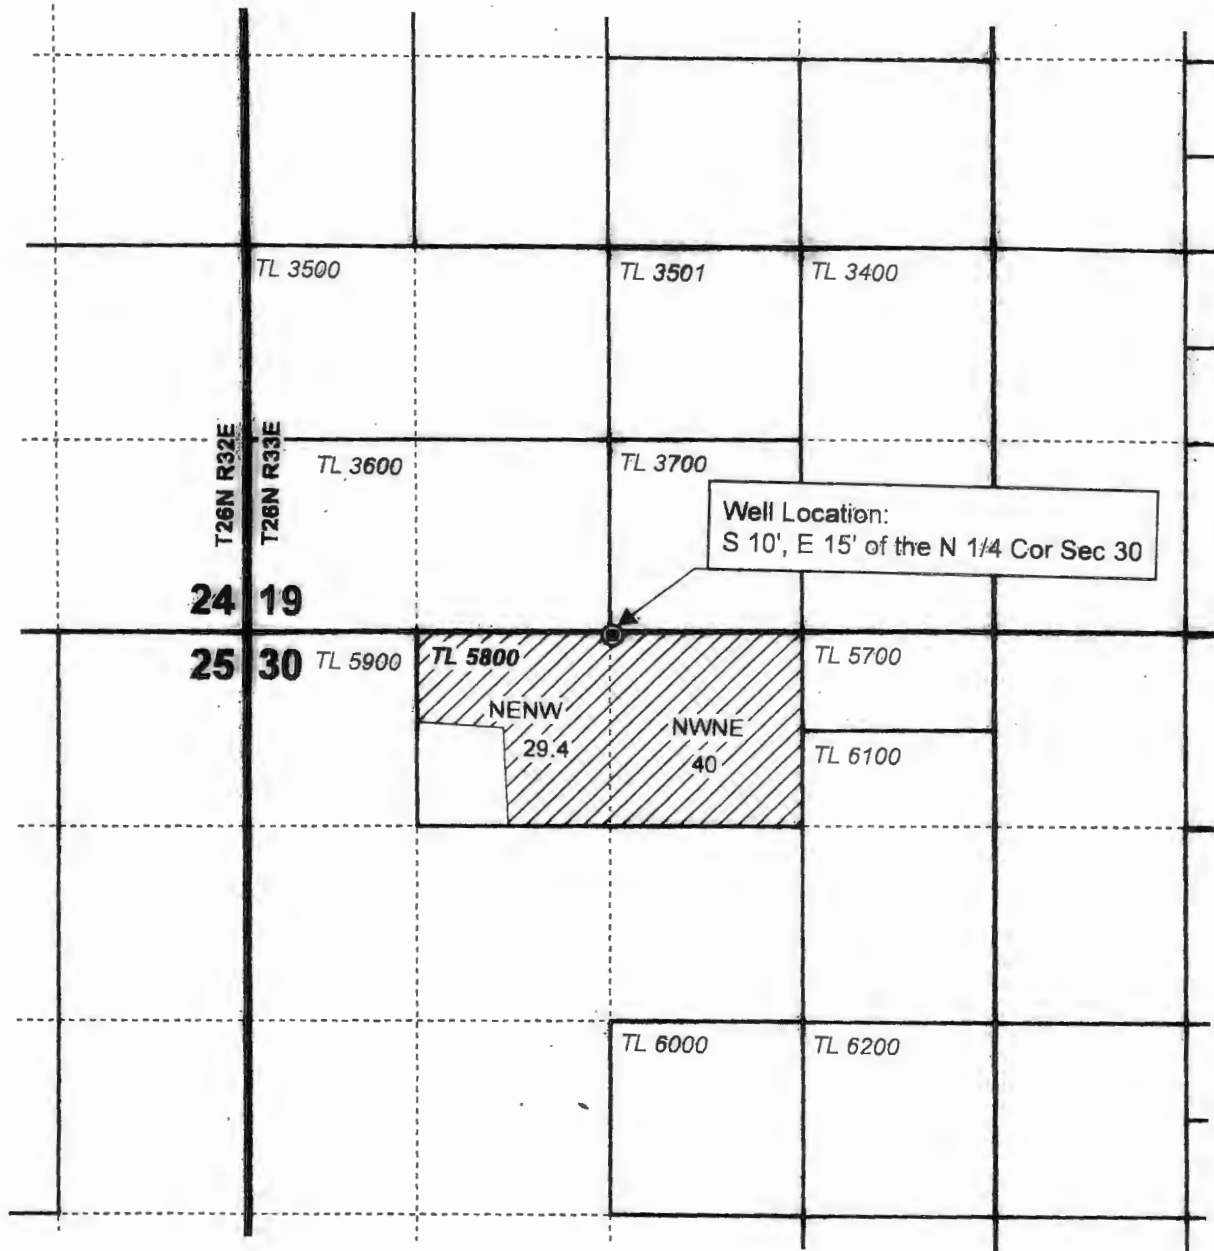

RENEWAL DATE 12/31/2019

RECEIVED

NOV 19 2018

WNR



**CLAIM OF BENEFICIAL USE MAP
BLACK RIDGE RANCH, LLC**

Date: 9/26/2018

Ap G-17028

Permit G-16473

Project #18020

This map is not intended
to provide legal dimensions
or locations of property
ownership lines.

WATER RIGHT SERVICES, LLC

PO BOX 1830, BEND, OR 97709

WWW.OREGONWATER.US CCB # 197121

johnshort@usa.com

541-389-2837