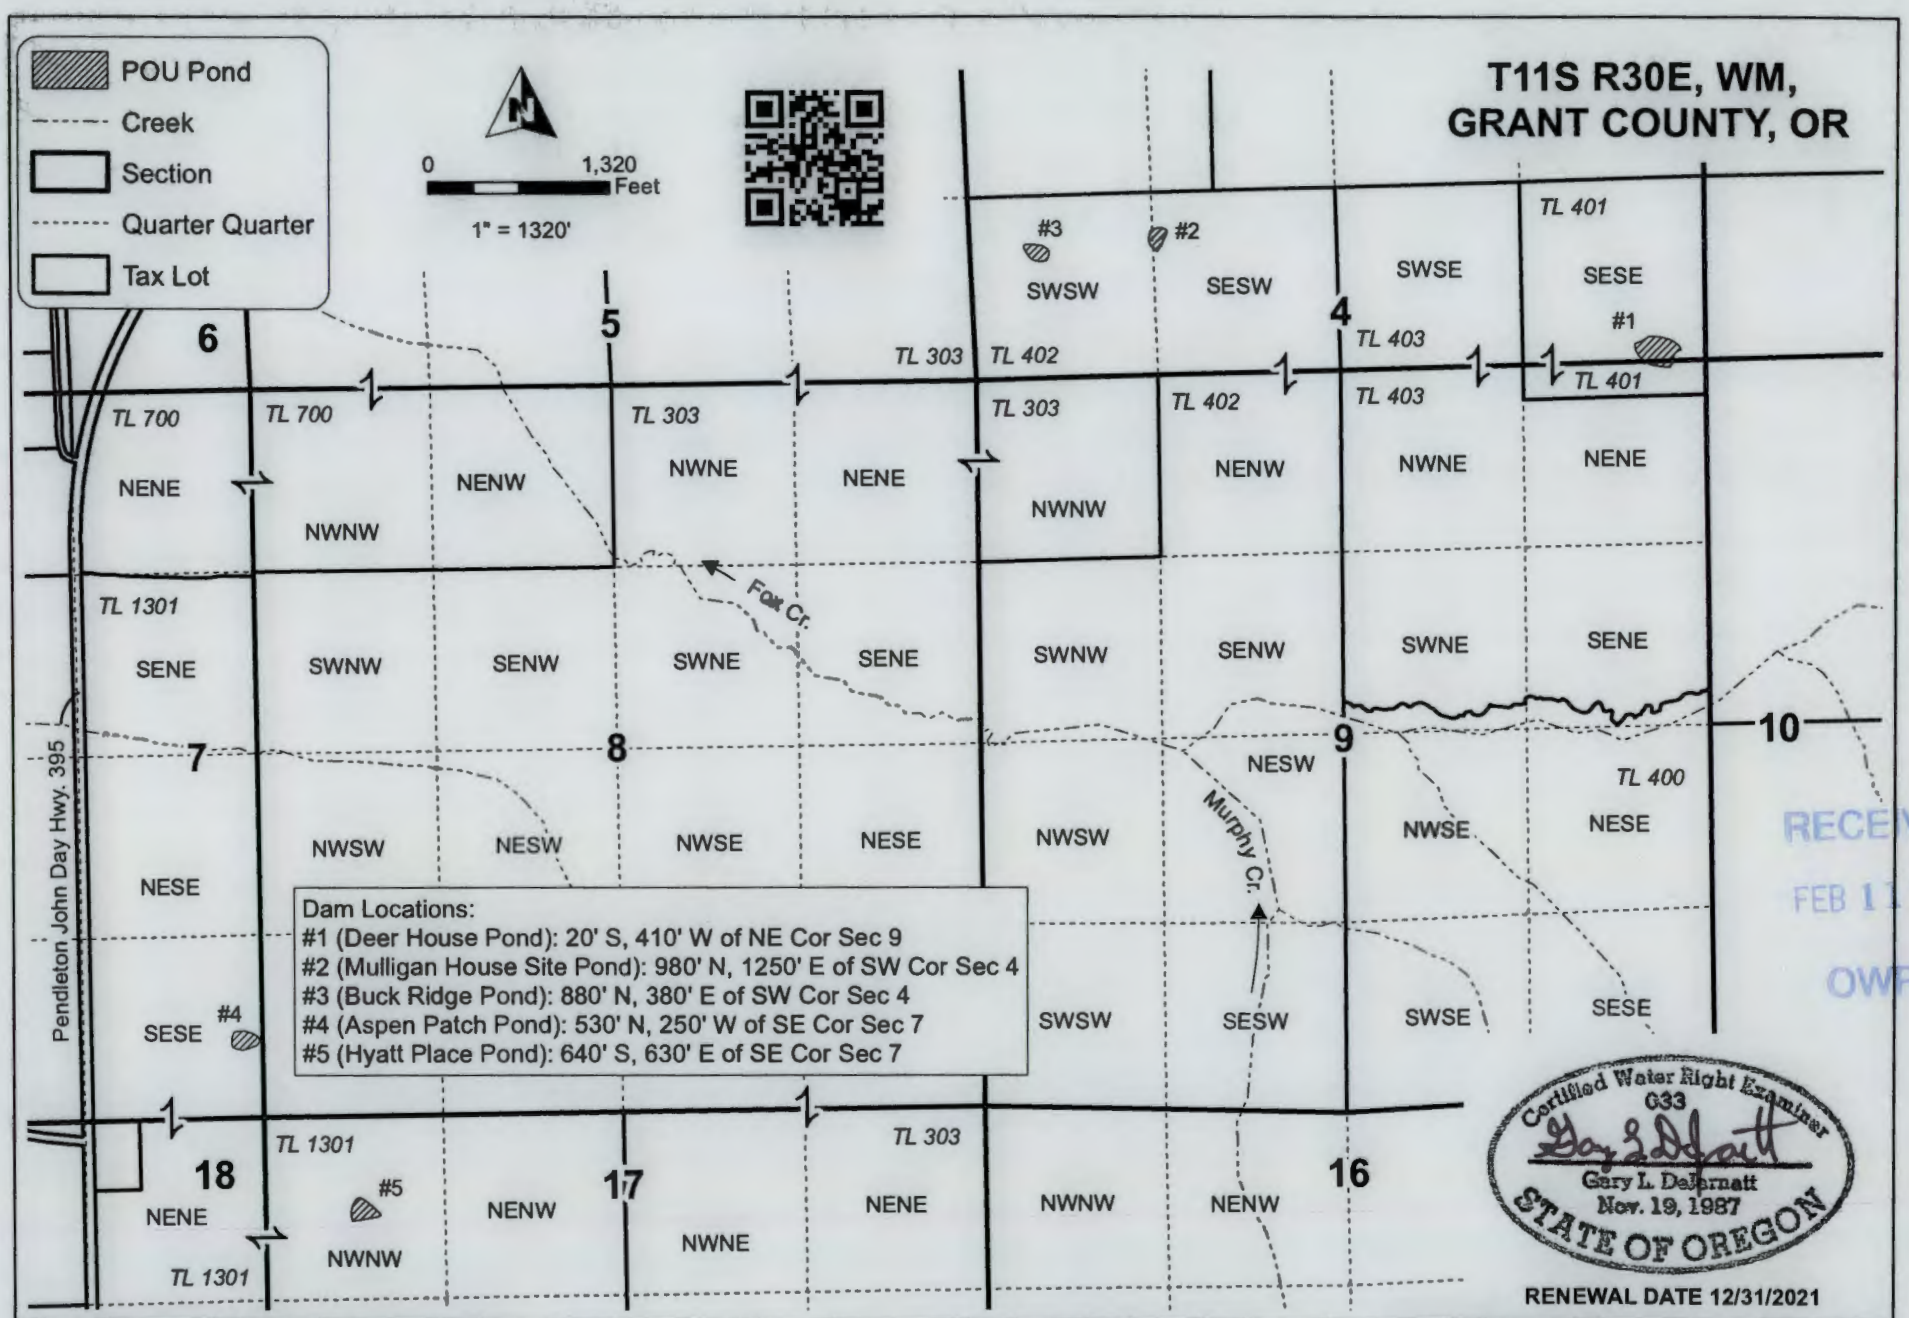


Certified Water Right Examiner
033
Gary L. DeJarnatt
Nov. 19, 1987
STATE OF OREGON

RENEWAL DATE 12/31/2021

RECEIVED
FEB 11 2022
OWRD

CLAIM OF BENEFICIAL USE MAP
FIVE SPRINGS RANCH

Ap R--87899 Permit R-15117 Project #20099 Date: 7/15/2021

This map is not intended to provide legal dimensions or locations of property ownership lines.

WATER RIGHT SERVICES, LLC
PO BOX 1830, BEND, OR 97709
WWW.OREGONWATER.US CCB # 197121
johnshort@usa.com 541-389-2837