


SE1/4 SEC 27 T.8S. R.3W. WM
MARION COUNTY, OREGON

B 3W 27D


SEE MAP B 3W 27A

DELETED TAX LOT
NUMBERS
01900
02500
01400
00101

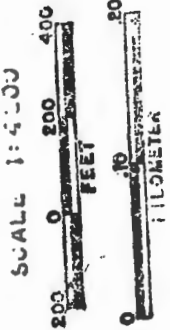

POND
40 FEET LONG
BY 30 FEET
WIDE

POND LOCATED
60 FEET EAST
OF HICKART LA.
AND 40 FEET
NORTH OF THE
SOUTH BOUNDARY

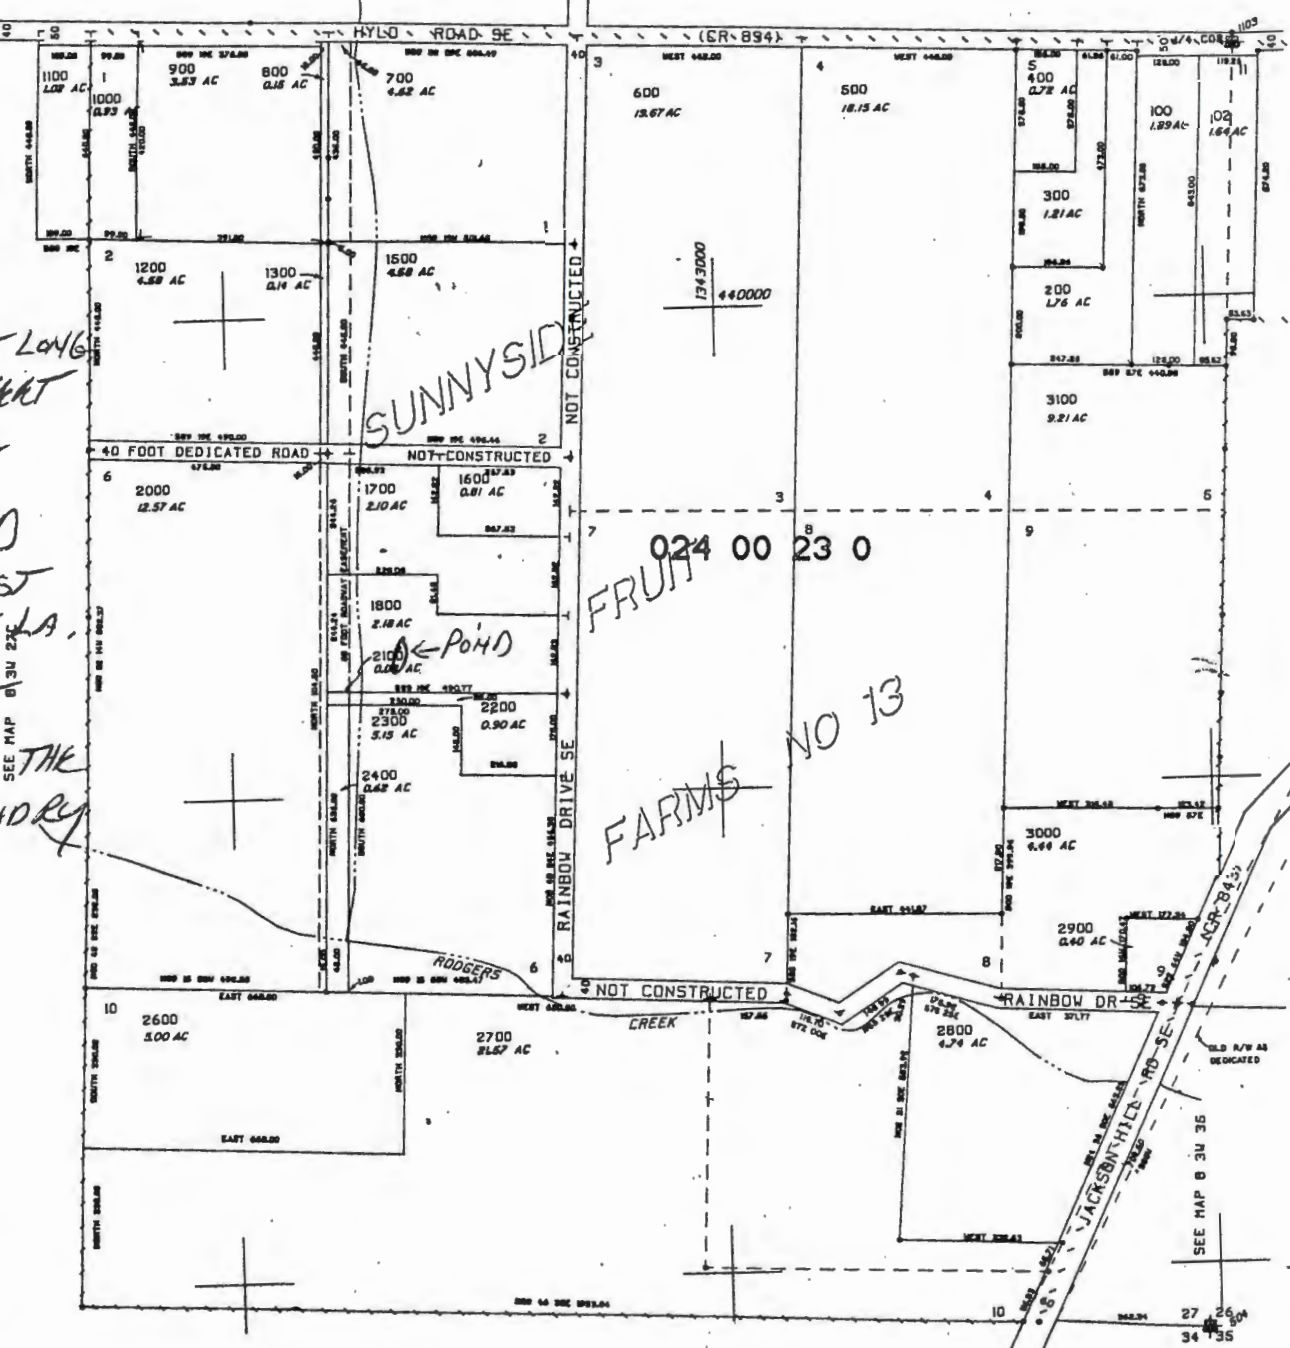

SUNNYSIDE

FRUIT
FARMS NO 13



1"=200'
28-OCT-81

Permit No. R12161
Application No. E-81586

OCT 03 1996

WARRANTY DEPT.
SALEM OREGON

RECORDED

SEE MAP B 3W 35

2/4 COR