


T.38S. R.4W. W.M.

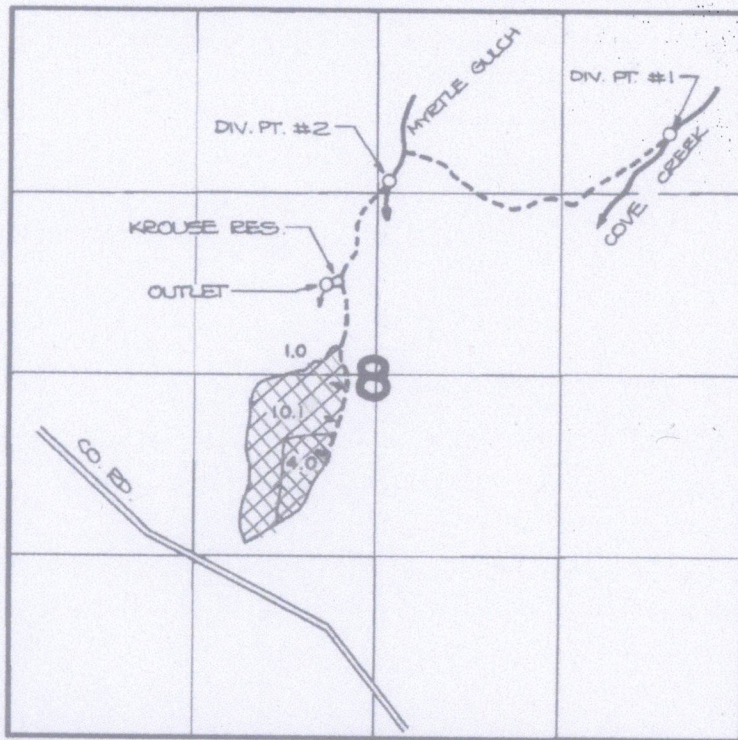

DIV. PT. #1 LOC: 1740' N. AND 560' W.; DIV. PT. #2 LOC: 1570' N. AND 2575' W.; BOTH FROM THE E. 1/4 CORNER OF SECTION 8.

 SUPPLEMENTAL

This map was created 4/2/2022 by Steven P. Boyd (CWRE #85312) to indicate POU location of supplemental irrigation in support of Affidavit for the Partial Diminution of Water Right Certificate #55681.