


R-6776C

If the diversion involves a dam, use this space for sketches of the diversion (e.g. cross-section of the dam with its dimensions, dimension and placement of outlet pipe, means of passing live flow outside of the authorized storage season, and means for providing fish passage).

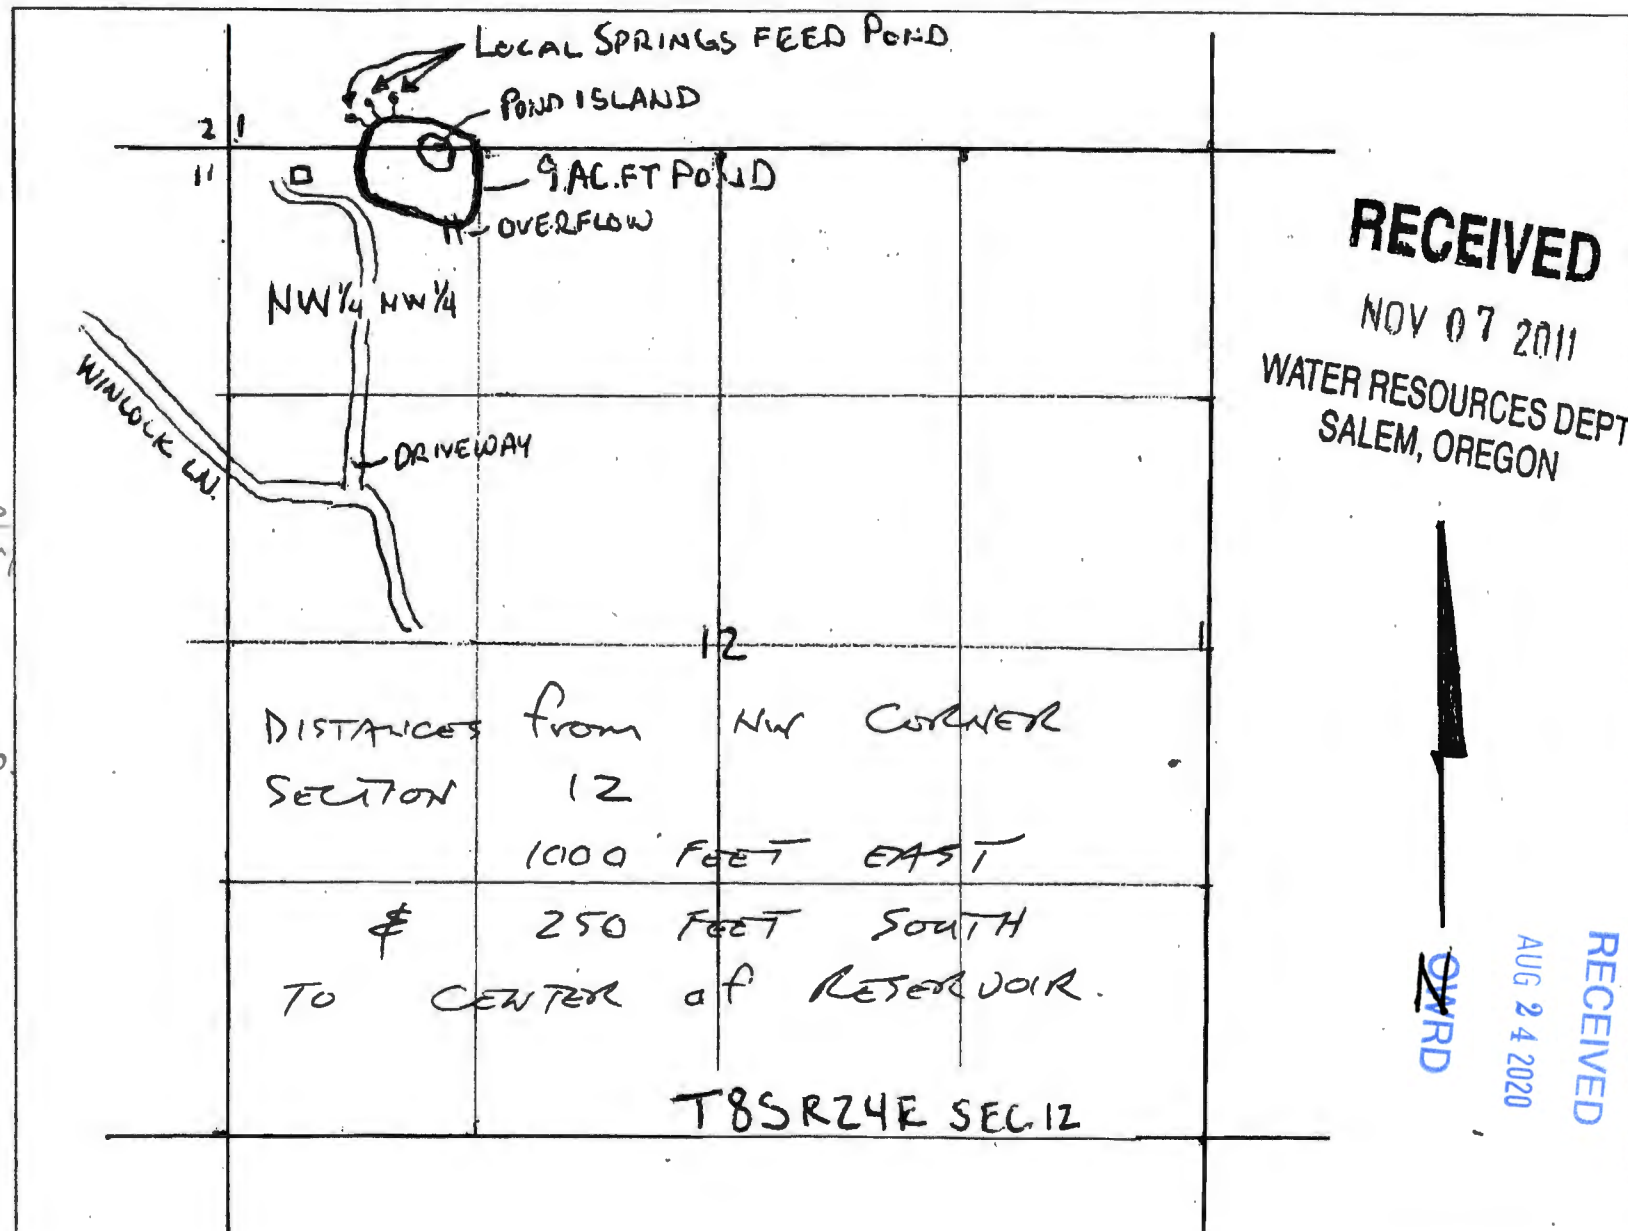

Use of
this map
discussed
by Kenneth
Thermon,
Water Master
in Wheeler County,
and Henry
Clark in
email
1:50 PM 8/17/20
Rabbs Goodell