

1" = 1320'

Tax Lot:


Township 4 South, Range 5 West, Section 4, Tax Lot 503

RECEIVED

SEP 07 2017



OWRD

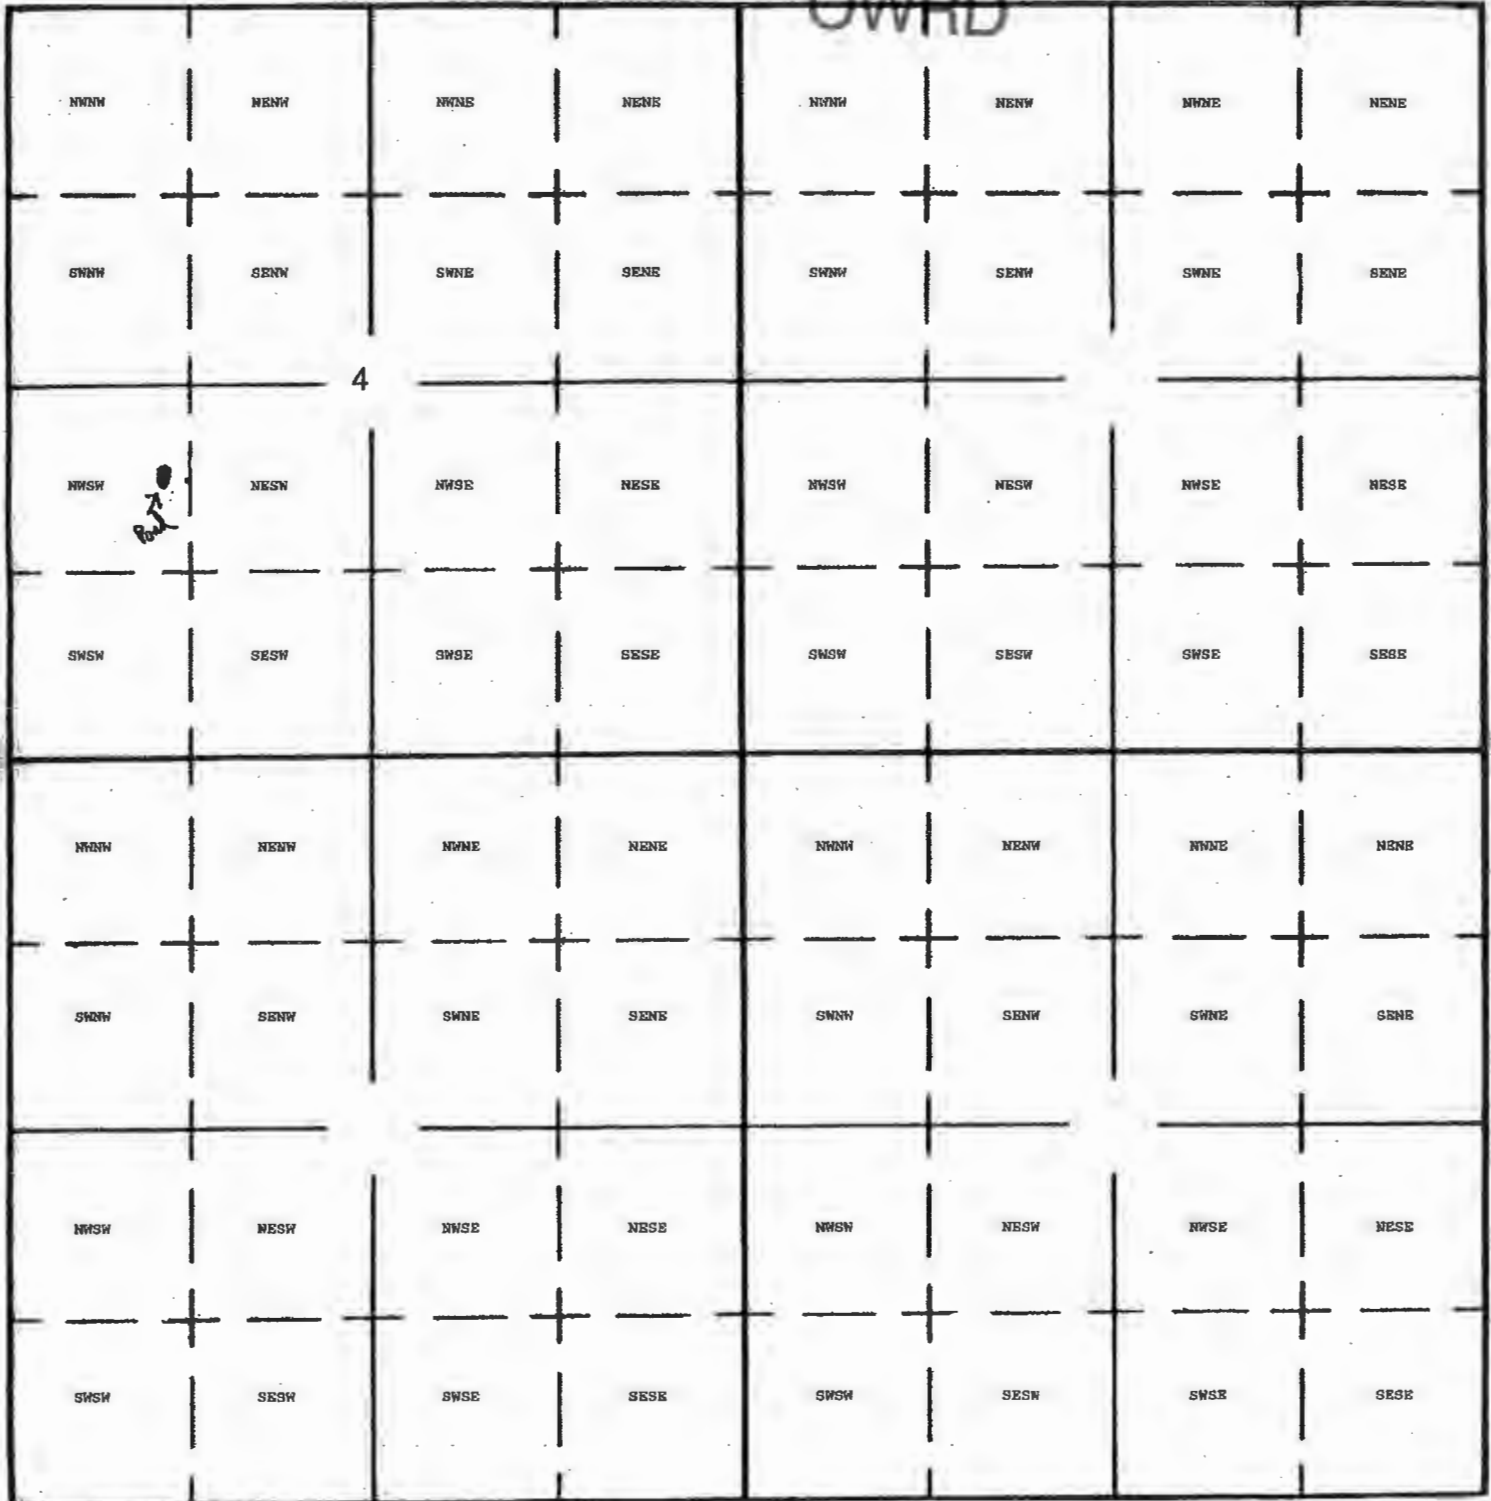

South

Dam Location: 1930 North and 1110 East from SW Corner Section 4