

CASSIDY RESRVIORS

T 19S- R 4W-WM SECTION 31
LANE COUNTY OREGON

SCALE 1 INCH = 200 FEET

~~RECEIVED~~
R-87534

RECEIVED

JUL 26 2021


NORTH

OWRD

RECEIVED

AUG 23 2021

OWRD

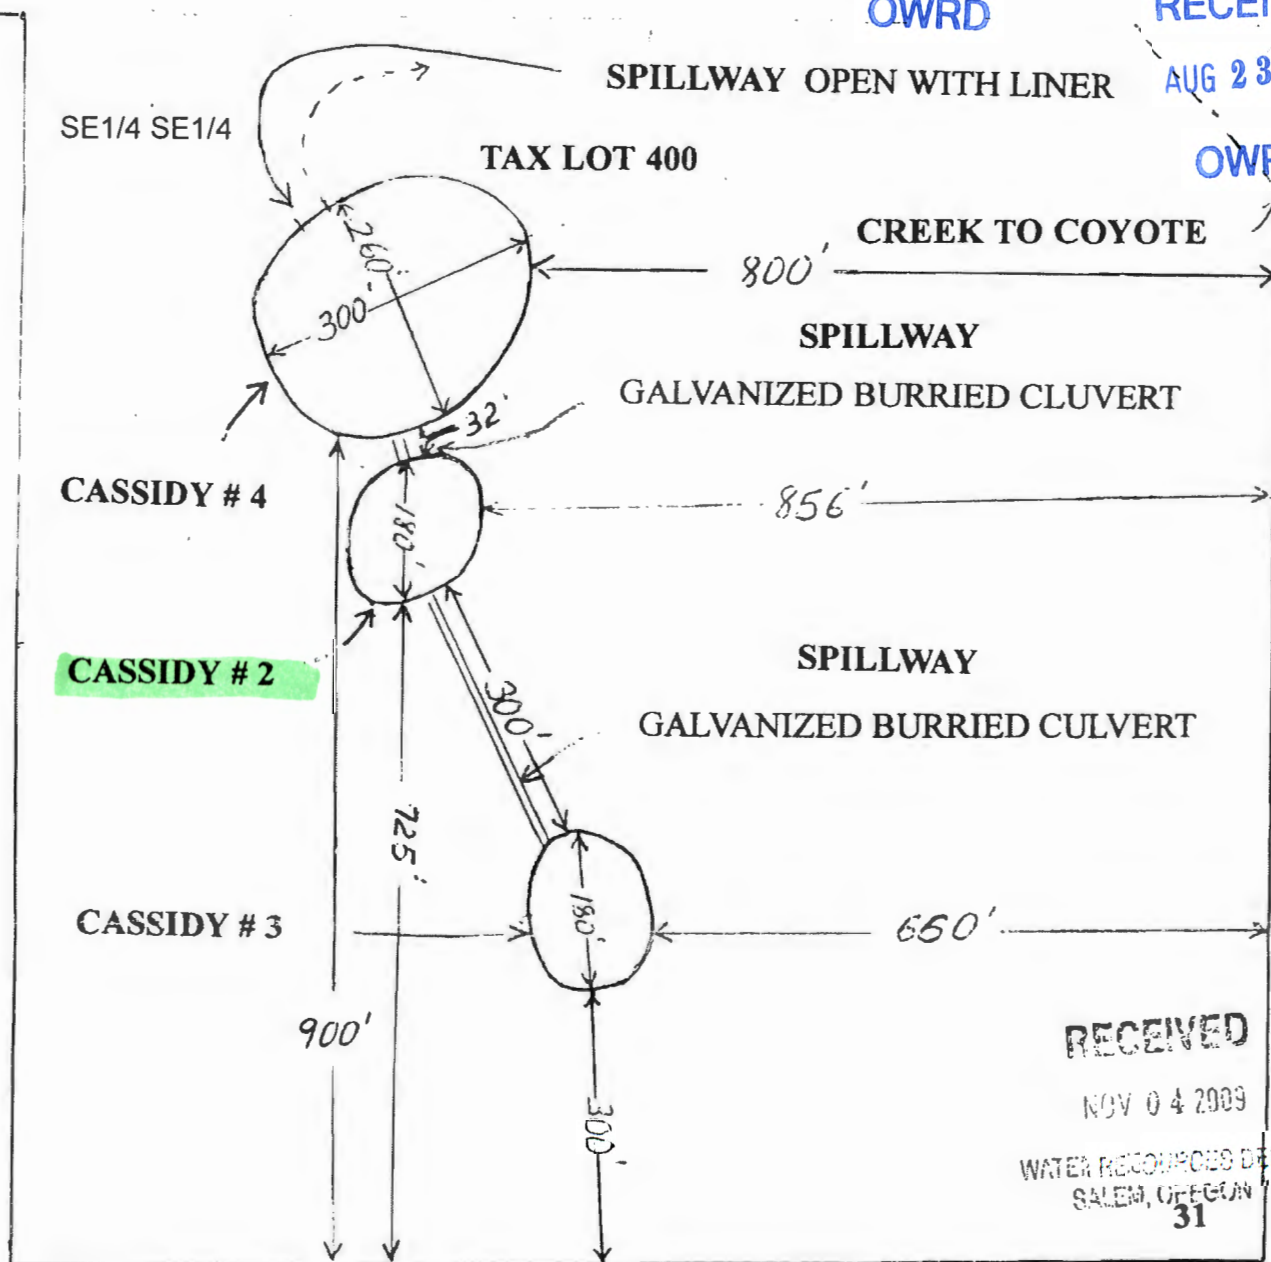

RECEIVED

NOV 04 2009

WATER RESOURCES DEPT
SALEM, OREGON

31

32

SOUTH EAST CORNER OF
T19 S-R4 W-SECTION 31