


Claim of Beneficial Use

Application R-87446, Permit R-15104

Township 3S, Range 4E, W.M.

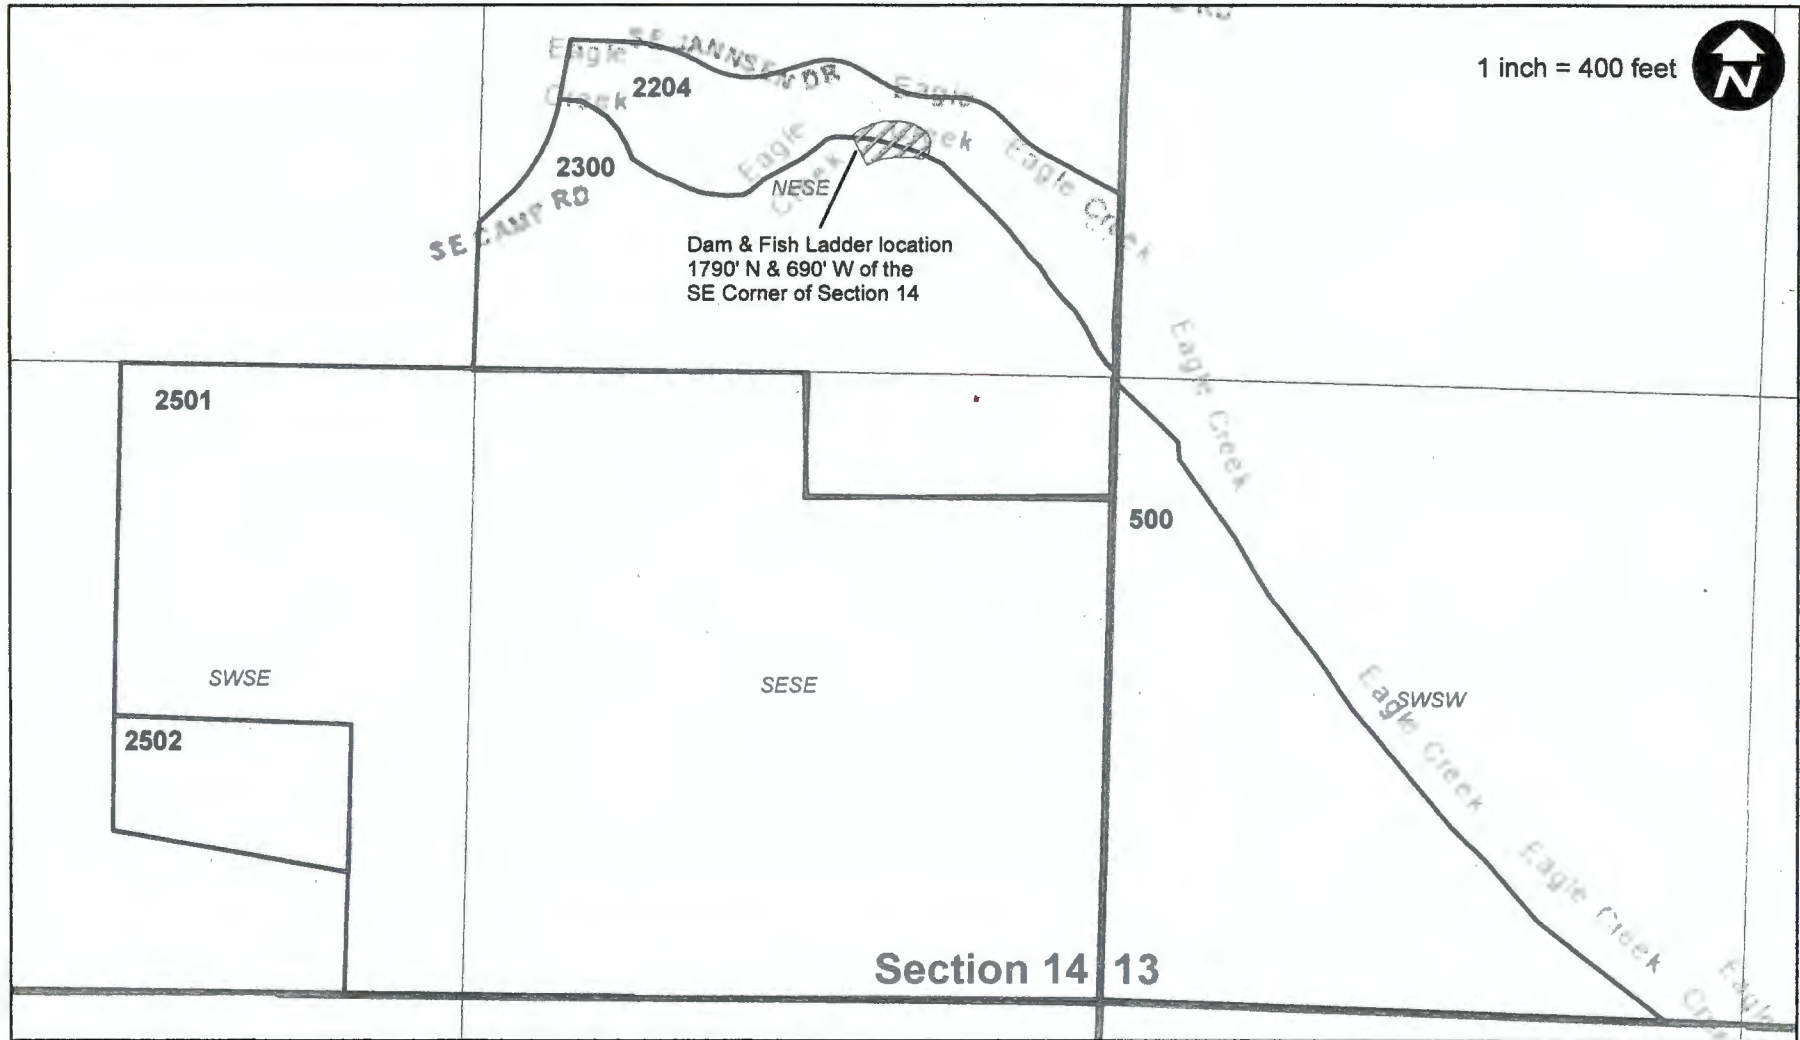

This map is not intended to provide legal dimensions or locations of property ownership lines.

Legend

 Reservoir  Tax Lots

RECEIVED

JUN 21 2021

OWRD

 WILL MCGILL SURVEYING LLC