
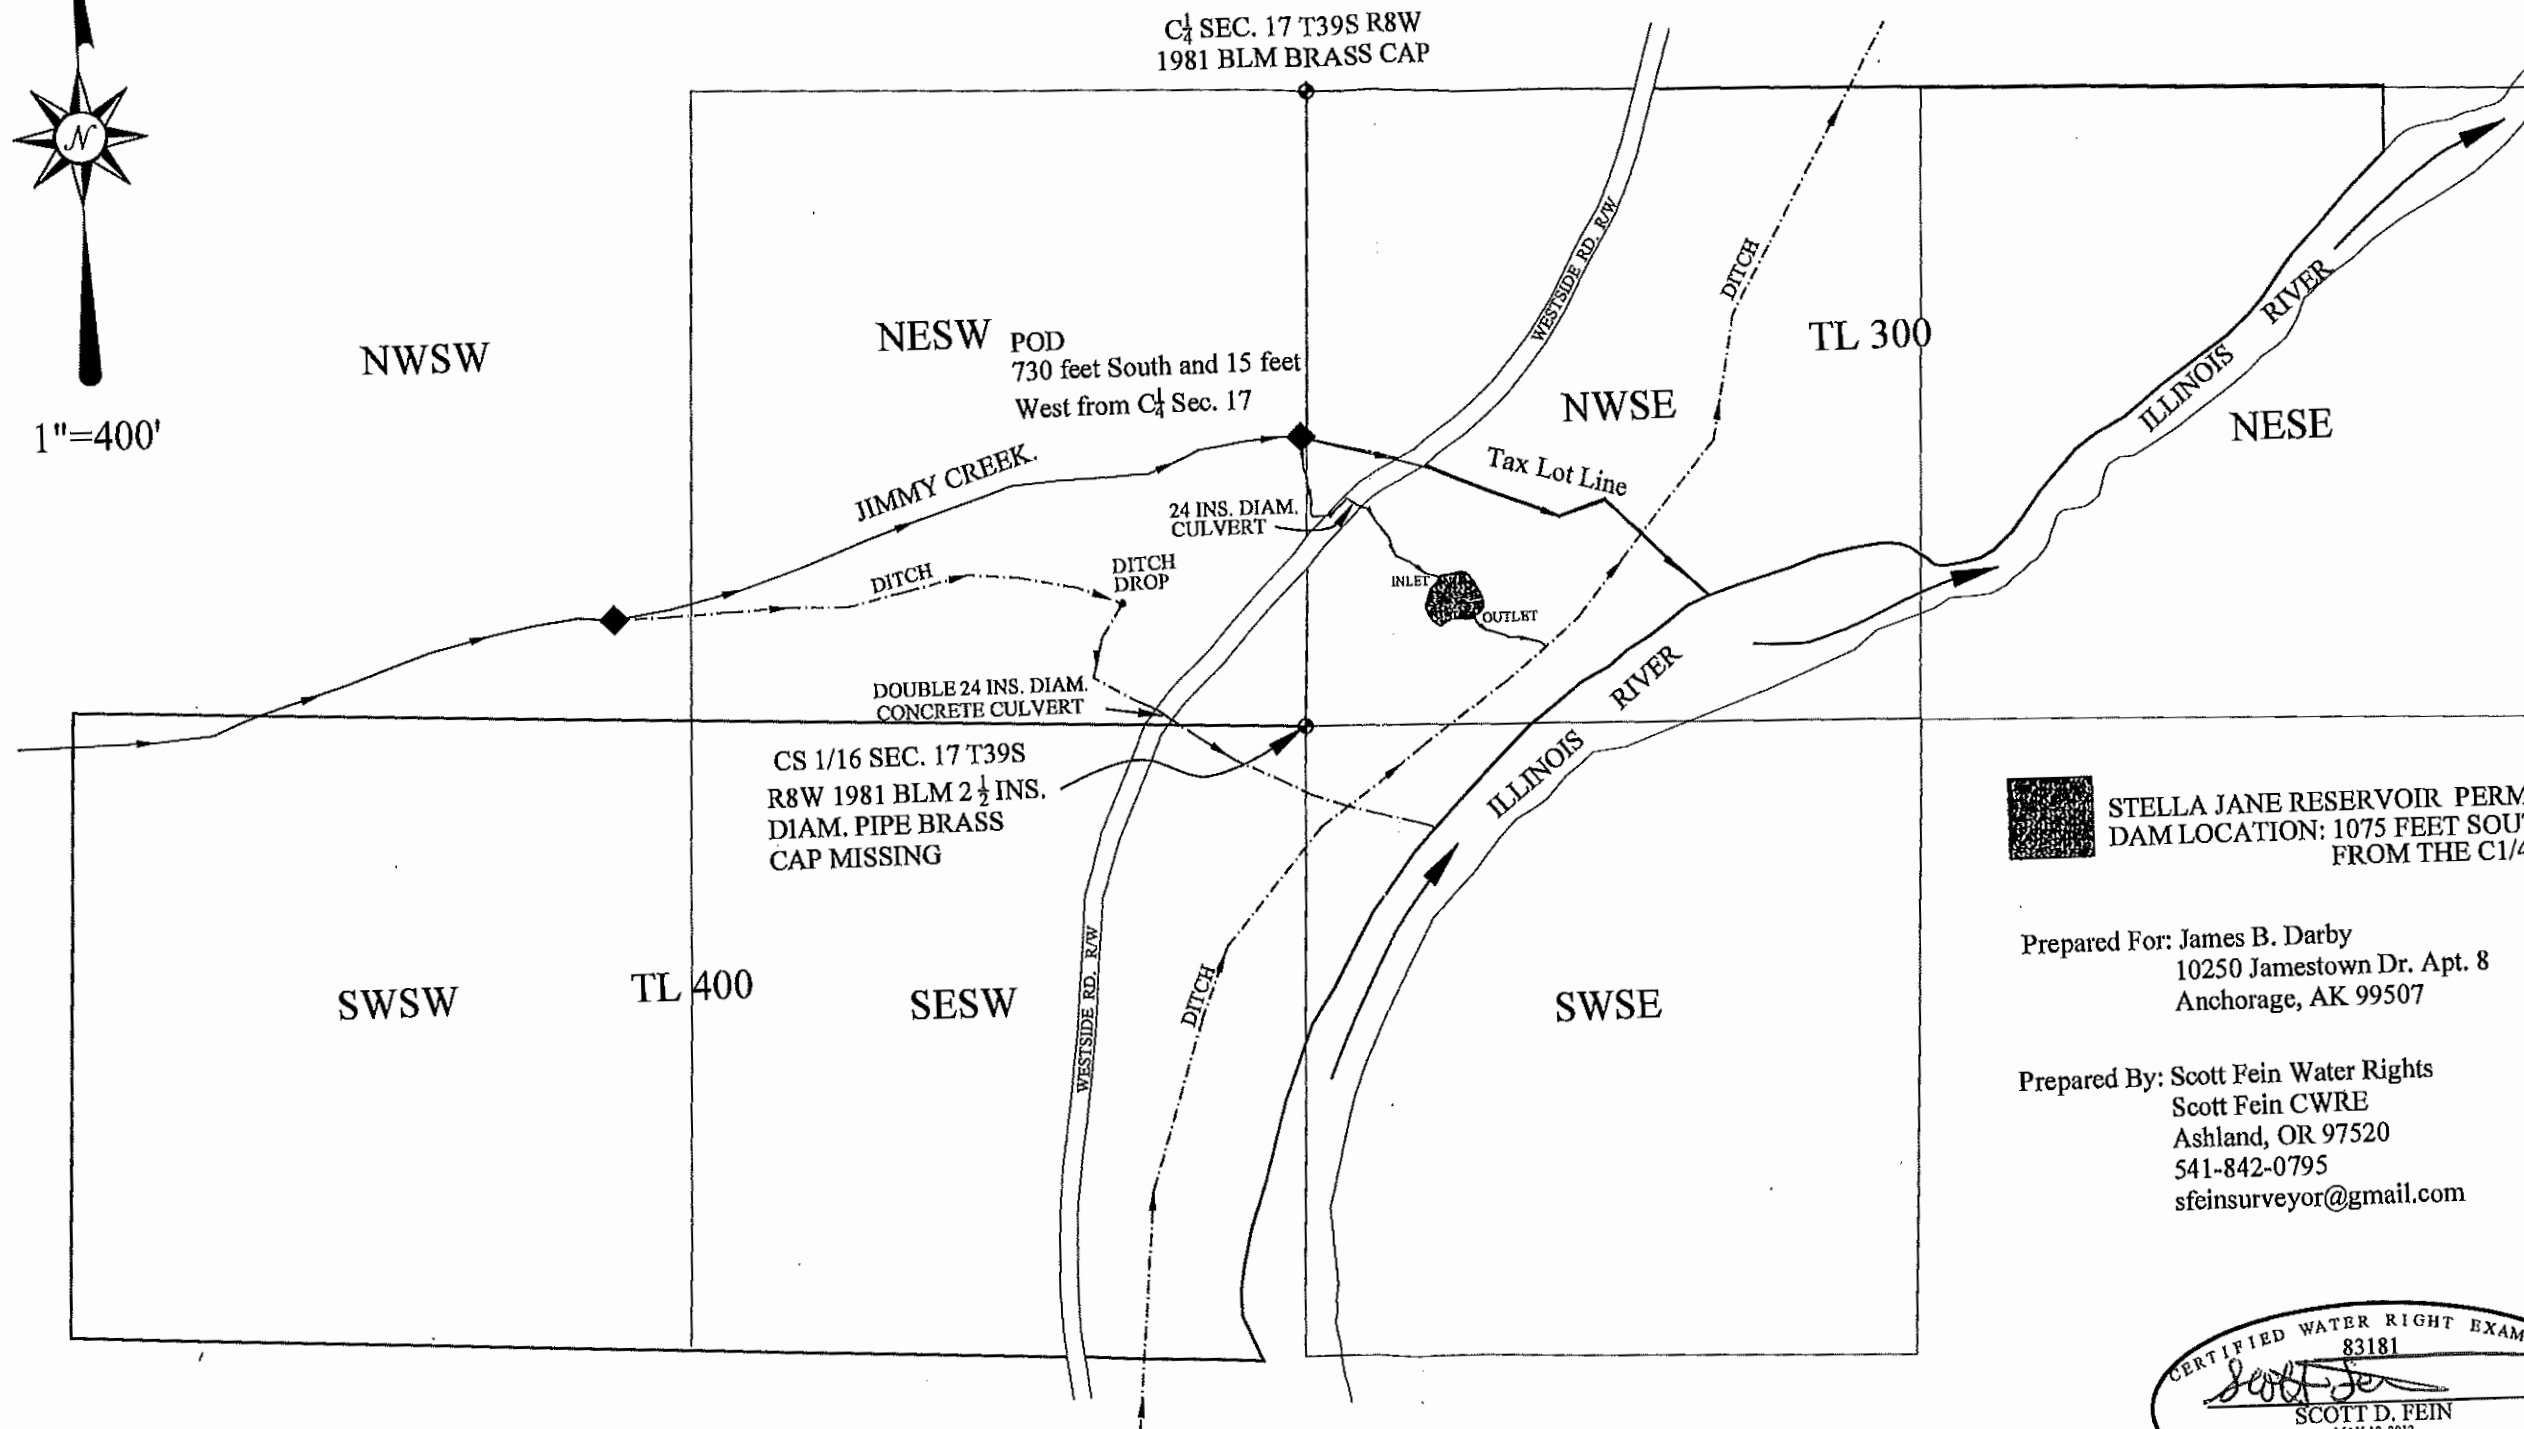



CLAIM OF BENEFICIAL USE SURVEY R-15216

Located in Township 39 South Range 8 West
NW1/4 of SE1/4 Section 17 Taxlot 400

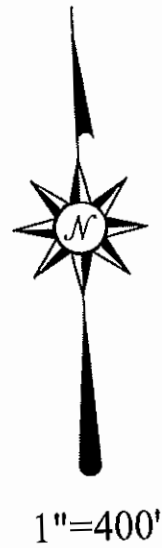


 STELLA JANE RESERVOIR PERMIT R-15216
 DAM LOCATION: 1075 FEET SOUTH & 330 FEET EAST
 FROM THE C¹/₄ SECTION 17

Prepared For: James B. Darby
 10250 Jamestown Dr. Apt. 8
 Anchorage, AK 99507

Prepared By: Scott Fein Water Rights
 Scott Fein CWRE
 Ashland, OR 97520
 541-842-0795
 sfeinsurveyor@gmail.com



10/3/2020

RECEIVED

APR 1 2021

OWRD

For Water Rights purposes only
 Not for property boundary locations or dimensions.
 No unauthorized use, reproduction or modification.