



# Claim of Beneficial Use New POD - Transfer T-13301 Pond, Eric M. & Laura R.

RECEIVED

APR 11 2022

OWRD

Township 12S, Range 1W, W.M.

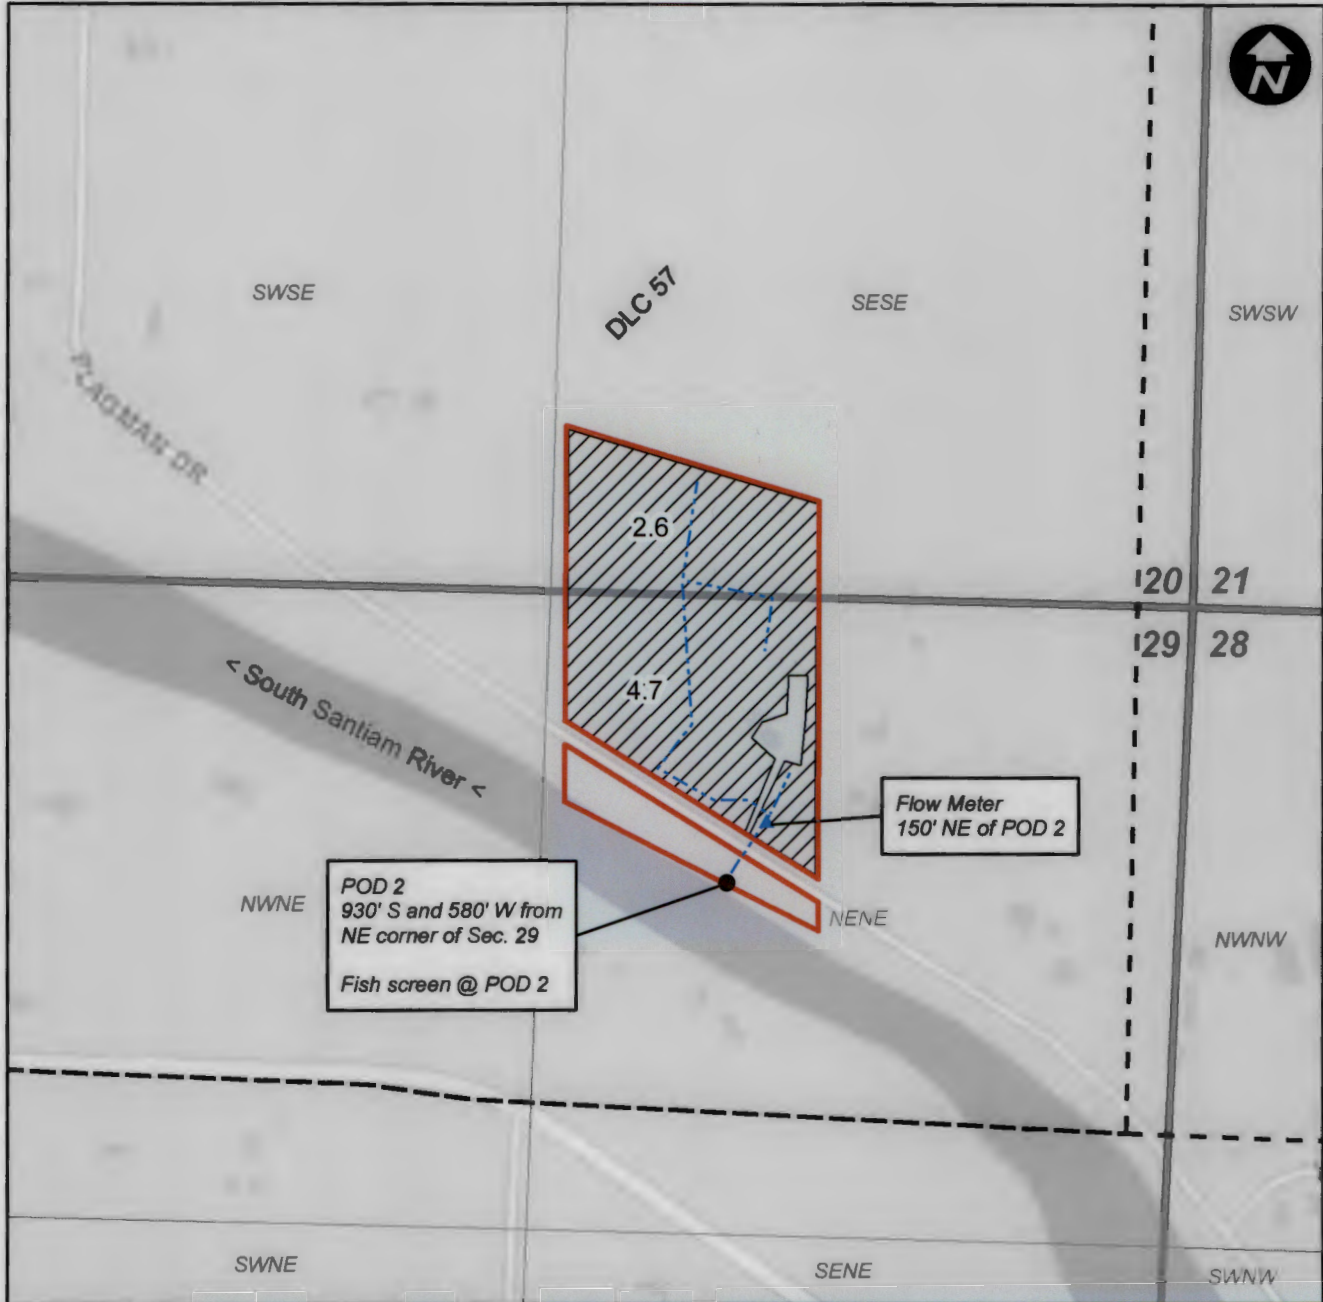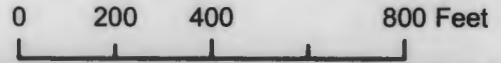

This map is not intended to provide legal dimensions or locations of property ownership lines.



### Legend

- T-13301 POU
- Mainline
- Taxlot 107
- DLC