

City of Rufus
Municipal Waterlines

Well No. 2
(Cancelled Certificate 34810)
1,930' S. & 50' W. of
S.E. Cor. Section 31

Parcel 2, tax lot 1900

2-200,000 gal Reservoirs

City of Rufus
WELL NO. 3 and FLOWMETER
1,087' S. & 1,113' W. of
N.E. Cor. Section 6
(Additional point
of diversion)

QUARTER CORNER
31 32

GOV'T.
LOT 2

Well No. 1
(Cancelled Certificates
31105 & 6767)
726' N. & 1,419' W. of S.E. Cor.
Section 31

COLUMBIA RIVER

TOWNSHIP 3 NORTH
TOWNSHIP 2 NORTH



SCALE: 1" = 1320'


SERVICE AREA
BOUNDARY

QUARTER CORNER

QUARTER CORNER

CORPORATE BOUNDARY

Transfer Claim of Beneficial Use Map
For
CITY OF RUFUS
Additional Point of Diversion (Well No. 3) for:
(Transfer T-9091)

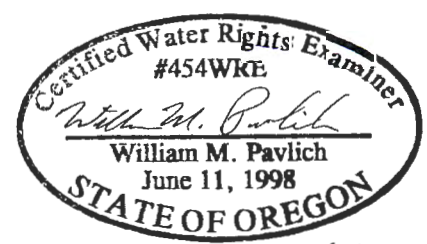

RECEIVED
FEB 22 2005
WATER RESOURCES DEPT
SALEM, OREGON

NOTE: This map has been prepared for Water Rights location only and is not
intended to provide legal dimensions or location of property ownership lines.