

City of Rufus  
Municipal Waterlines

Well No. 2  
(Cancelled Certificate 34810)  
1,930' S. & 50' W. of  
S.E. Cor. Section 31

Parcel 2, tax lot 1900

2-200,000 gal Reservoirs

City of Rufus  
WELL NO. 3 and FLOWMETER  
1,087' S. & 1,113' W. of  
N.E. Cor. Section 6  
(Additional point  
of diversion)

QUARTER CORNER  
31 32

GOV'T.  
LOT 2

Well No. 1  
(Cancelled Certificates  
31105 & 6767)  
726' N. & 1,419' W. of S.E. Cor.  
Section 31

COLUMBIA RIVER

36 31  
1 6  
TOWNSHIP 3 NORTH  
TOWNSHIP 2 NORTH

31 32  
6 5



SCALE: 1" = 1320'


SERVICE AREA  
BOUNDARY

QUARTER CORNER

QUARTER CORNER

CORPORATE BOUNDARY

Transfer Claim of Beneficial Use Map  
For  
CITY OF RUFUS  
Additional Point of Diversion (Well No. 3) for:  
(Transfer T-9091)

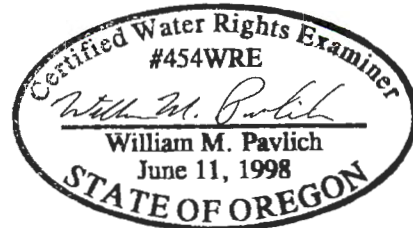

Expires: 12/31/06

**RECEIVED**

FEB 22 2005

WATER RESOURCES DEPT  
SALEM, OREGON

NOTE: This map has been prepared for Water Rights location only and is not  
intended to provide legal dimensions or location of property ownership lines.