

City of Rufus
Municipal Waterlines

SCALE: 1" = 400'

CHINA HOLLOW RD
GIRKING RD.

Well No. 2
(Cancelled Certificate 34810)
1,930' S. & 50' W. of
S.E. Cor. Section 31

Parcel 2, tax lot 1900

2-200,000 gal Reservoirs

City of Rufus
WELL NO. 3 and FLOWMETER
1,087' S. & 1,113' W. of
N.E. Cor. Section 6
(Additional point
of diversion)

QUARTER CORNER
31 32

GOV'T.
LOT 2

Well No. 1
(Cancelled Certificates
31105 & 6767)
726' N. & 1,419' W. of S.E. Cor.
Section 31

COLUMBIA RIVER

36 31
1 6
TOWNSHIP 3 NORTH
TOWNSHIP 2 NORTH

31 32
6 5



SCALE: 1" = 1320'

RANGE 26 EAST
RANGE 27 EAST


SERVICE AREA
BOUNDARY

QUARTER CORNER

QUARTER CORNER

CORPORATE BOUNDARY

Transfer Claim of Beneficial Use Map
For
CITY OF RUFUS
Additional Point of Diversion (Well No. 3) for:
(Transfer T-9291)

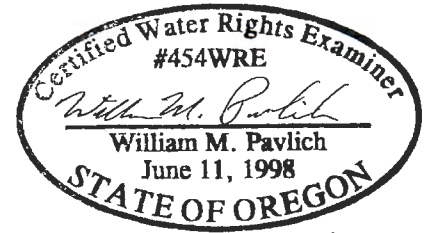

RECEIVED
FEB 22 2005
WATER RESOURCES DEPT
SALEM, OREGON

NOTE: This map has been prepared for Water Rights location only and is not intended to provide legal dimensions or location of property ownership lines.