


# CLAIM OF BENEFICIAL USE MAP

TO ADD PLACE OF USE AND POINTS OF APPROPRIATION  
FOR APPLICATION G-17677

SECTIONS 28 & 29, TOWNSHIP 25 SOUTH, RANGE 29 EAST, W.M.  
TAX LOTS: 900, 2300, 2400, & 2500

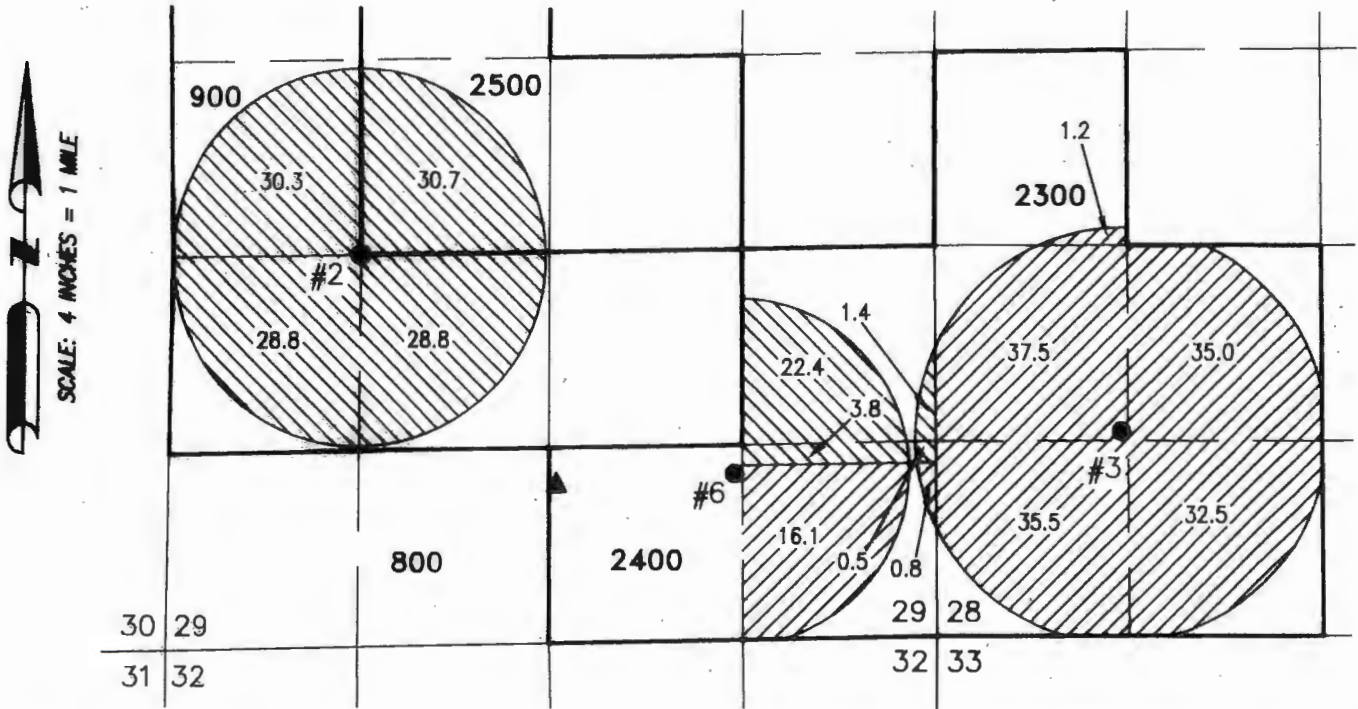

- **POA 2 (HARN 1084)**  
LOCATED IN THE NE 1/4 SW 1/4 SECTION 29, T25S R29E, W.M. AND 0 FEET SOUTH AND 1320 FEET EAST FROM THE W 1/4 CORNER OF SECTION 29. FLOW METER LOCATED 4 FEET SE OF CENTER PIVOT SPRINKLER.
- **POA 3 (HARN 52603)**  
LOCATED IN THE NW 1/4 SW 1/4 SECTION 28, T25S R29E, W.M. AND 1262 FEET SOUTH AND 1280 FEET EAST FROM THE W 1/4 CORNER OF SECTION 28. FLOW METER LOCATED 5 FEET N OF CENTER PIVOT SPRINKLER.
- **POA 6 (L129728)**  
LOCATED IN THE SW 1/4 SE 1/4 SECTION 29, T25S R29E, W.M. AND 1525 FEET SOUTH AND 1370 FEET WEST FROM THE E 1/4 CORNER OF SECTION 29. FLOW METER LOCATED 3 FEET S OF CENTER PIVOT SPRINKLER.

158.6 AC IR FROM POAS 3 & 6 (PERMIT G-17928)

146.7 AC IS FROM POAS 2, 3, & 6 (PERMIT G-17928)


\* 1.9 AC IR DIMINISHED TO IS

THIS MAP IS FOR THE PURPOSE OF LOCATING A WATER RIGHT ONLY AND HAS NO INTENT TO PROVIDE LEGAL DIMENSIONS OR THE LOCATION OF PROPERTY LINES.

▲ OBS WELL (HARN 52534) IN THE SW 1/4 OF THE SE 1/4 SECTION 29 & 1585' SOUTH & 2585' WEST FROM THE E 1/4 CORNER SECTION 29.



RENEWAL DATE: 12/31/2020

<p>PREPARED FOR:</p> <p>WILLIAM AND LORI PEILA P.O. BOX 723 HINES, OR 97738</p>	<p>PREPARED BY:</p>  <p>ALL POINTS ENGINEERING AND SURVEYING, INC. P.O. BOX 767 TERREBONNE, OR 97760 (541) 548-5833 www.APEandS.com</p>
---	--