




RECEIVED
NOV 28 2020
OWRD

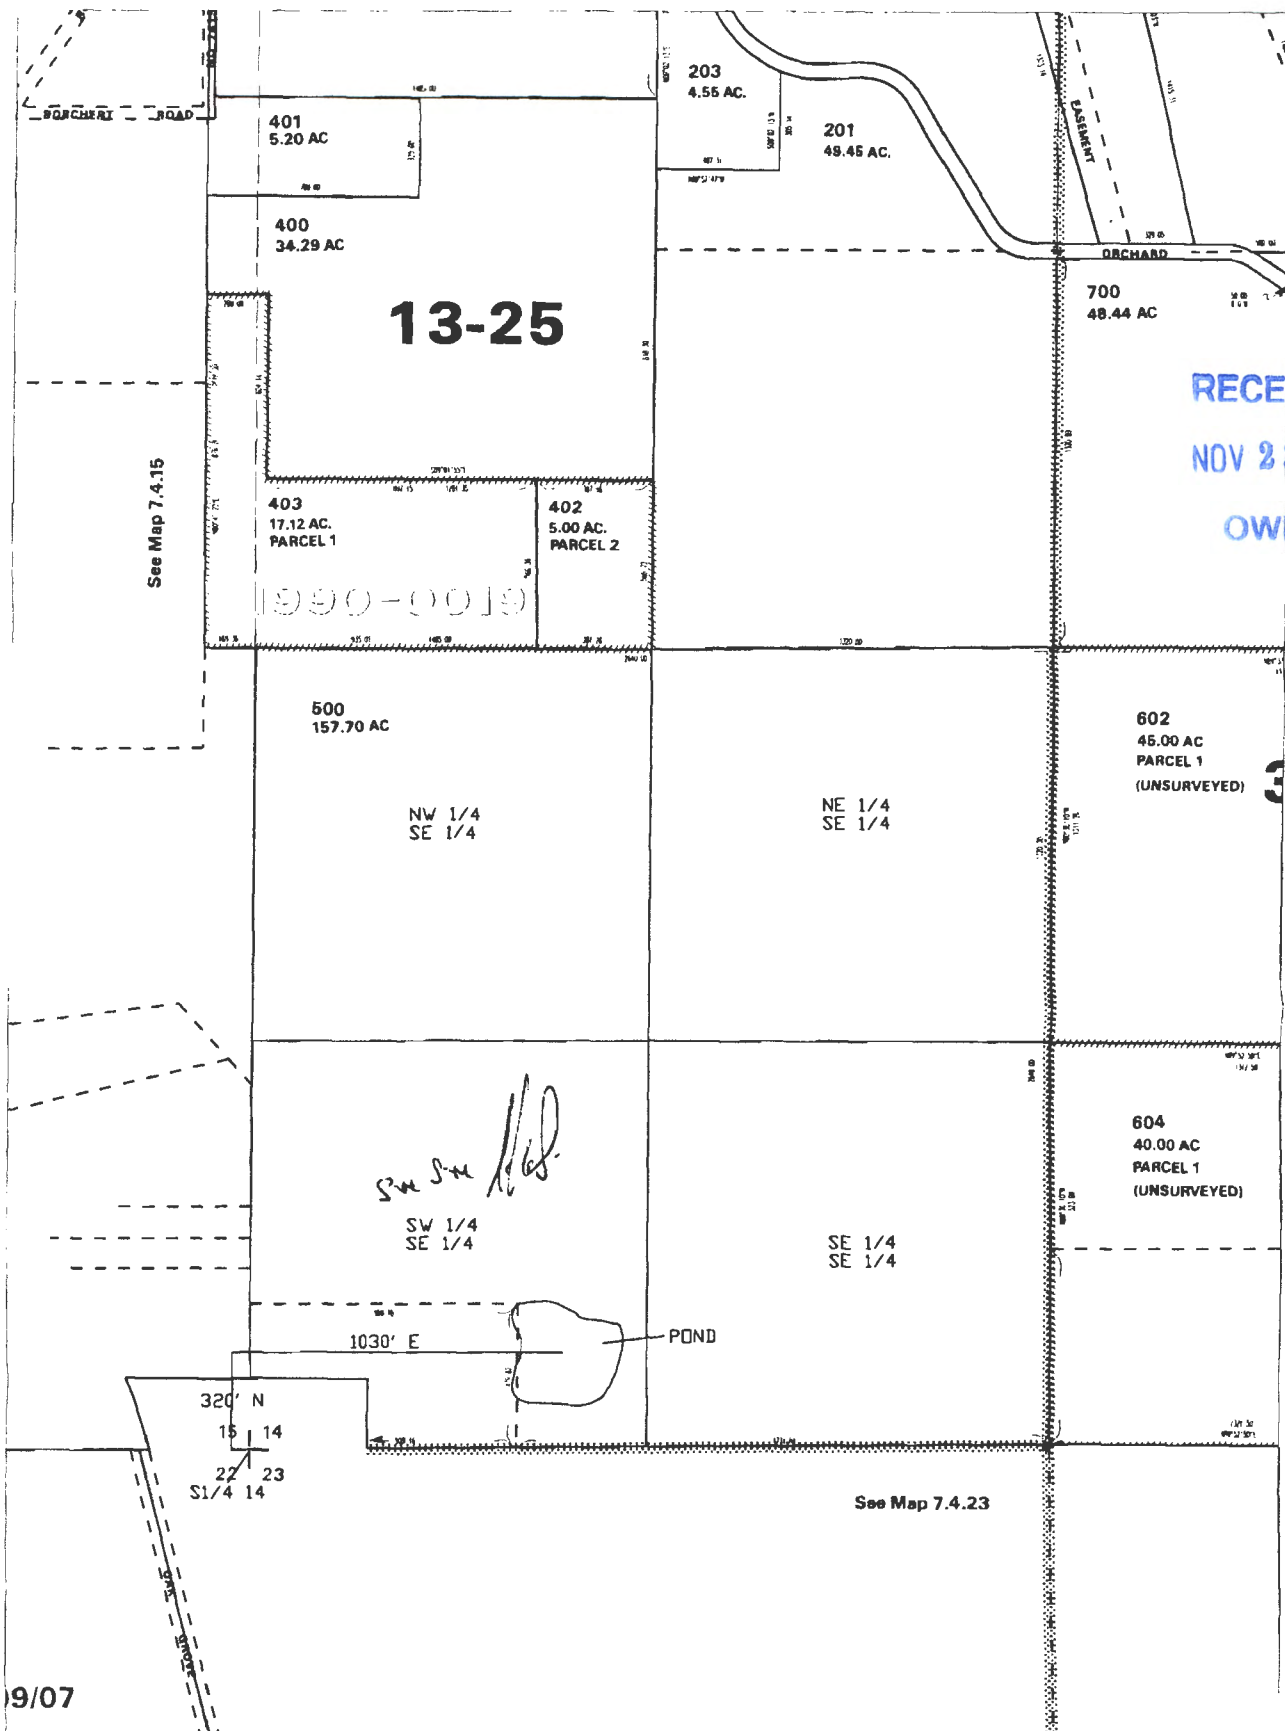

POND is N 320' & E 1030'
of ~~S1/4~~ Sec 14
See Cox - Puc. 14

R-97348

RECEIVED
NOV 21 2008
T7S R4W WM
POLK COUNTY
SCALE: 1" = 400'
0' 400'