


3rd

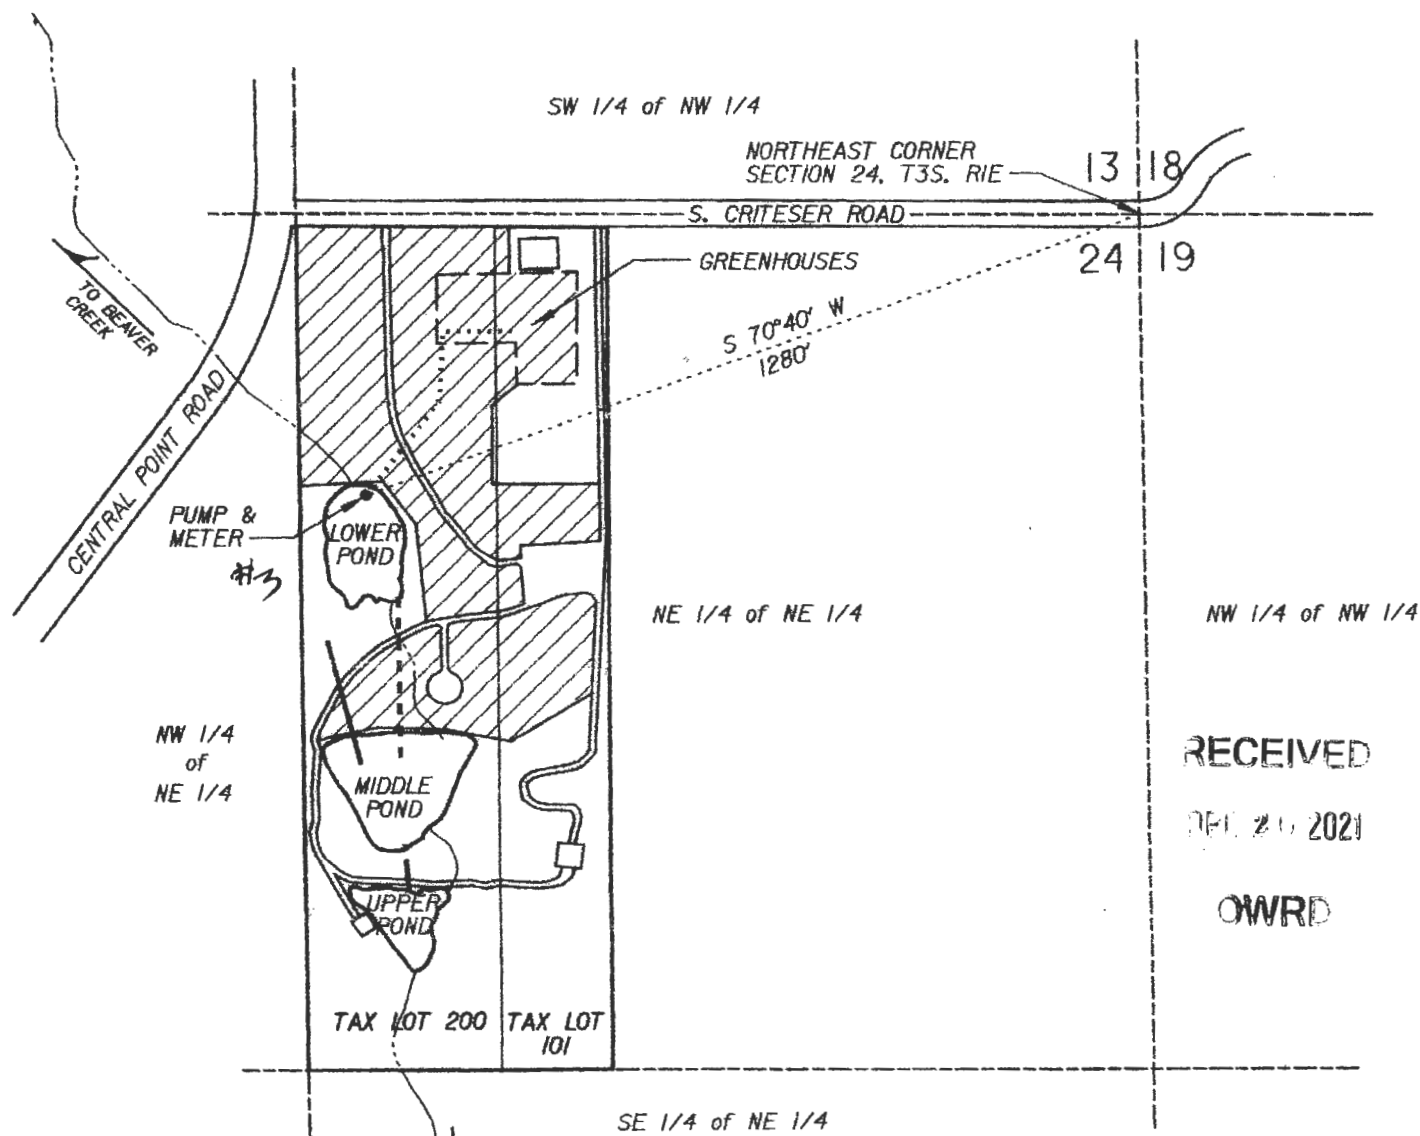

LEGEND:

- IRRIGATED LAND
- BURIED 10" ADS OVERFLOW
- BURIED 8" PVC MAINLINE
- BURIED 6" ADS MAINLINE
- BURIED 2" PVC MAINLINE
- STRUCTURES

NOTES:

THIS DRAWING IS A PROOF SURVEY FOR A CLAIM OF BENEFICIAL USE TO PERFECT A SURFACE WATER RIGHT. IT IS NOT A LAND SURVEY. PROPERTY LINES AND/OR OTHER LINES OF OCCUPATION SHOWN HEREON ARE NOT REPRESENTED BY THE UNDERSIGNED TO MEET ACCURACY STANDARDS OF LAND SURVEYS.



SCALE: 1" = 300'

RECEIVED

DEC 20 2021

OWRD

NE 1/4, NE 1/4
SECTION 24, T.3S., R.1E., W.M.
CLACKAMAS COUNTY, OREGON


5.4 TOTAL ACRES OF PASTURE,
NURSERY STOCK, GREENHOUSES
& GRAPES UNDER IRRIGATION

APPLICATION No.

PERMIT No.

87561
S-
S-
1492

BURL MOSTUL SURFACE WATER PROOF SURVE

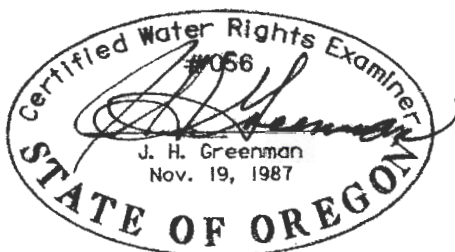

2018/05/14



**HANER, ROSS &
SPORSEEN, P.C.**

2895 Beaver Creek Road,
Oregon City, OR 97045

L:\HRS_1670\ 1670_DGN\ 1670_PROOFSURVEY_R1.D