



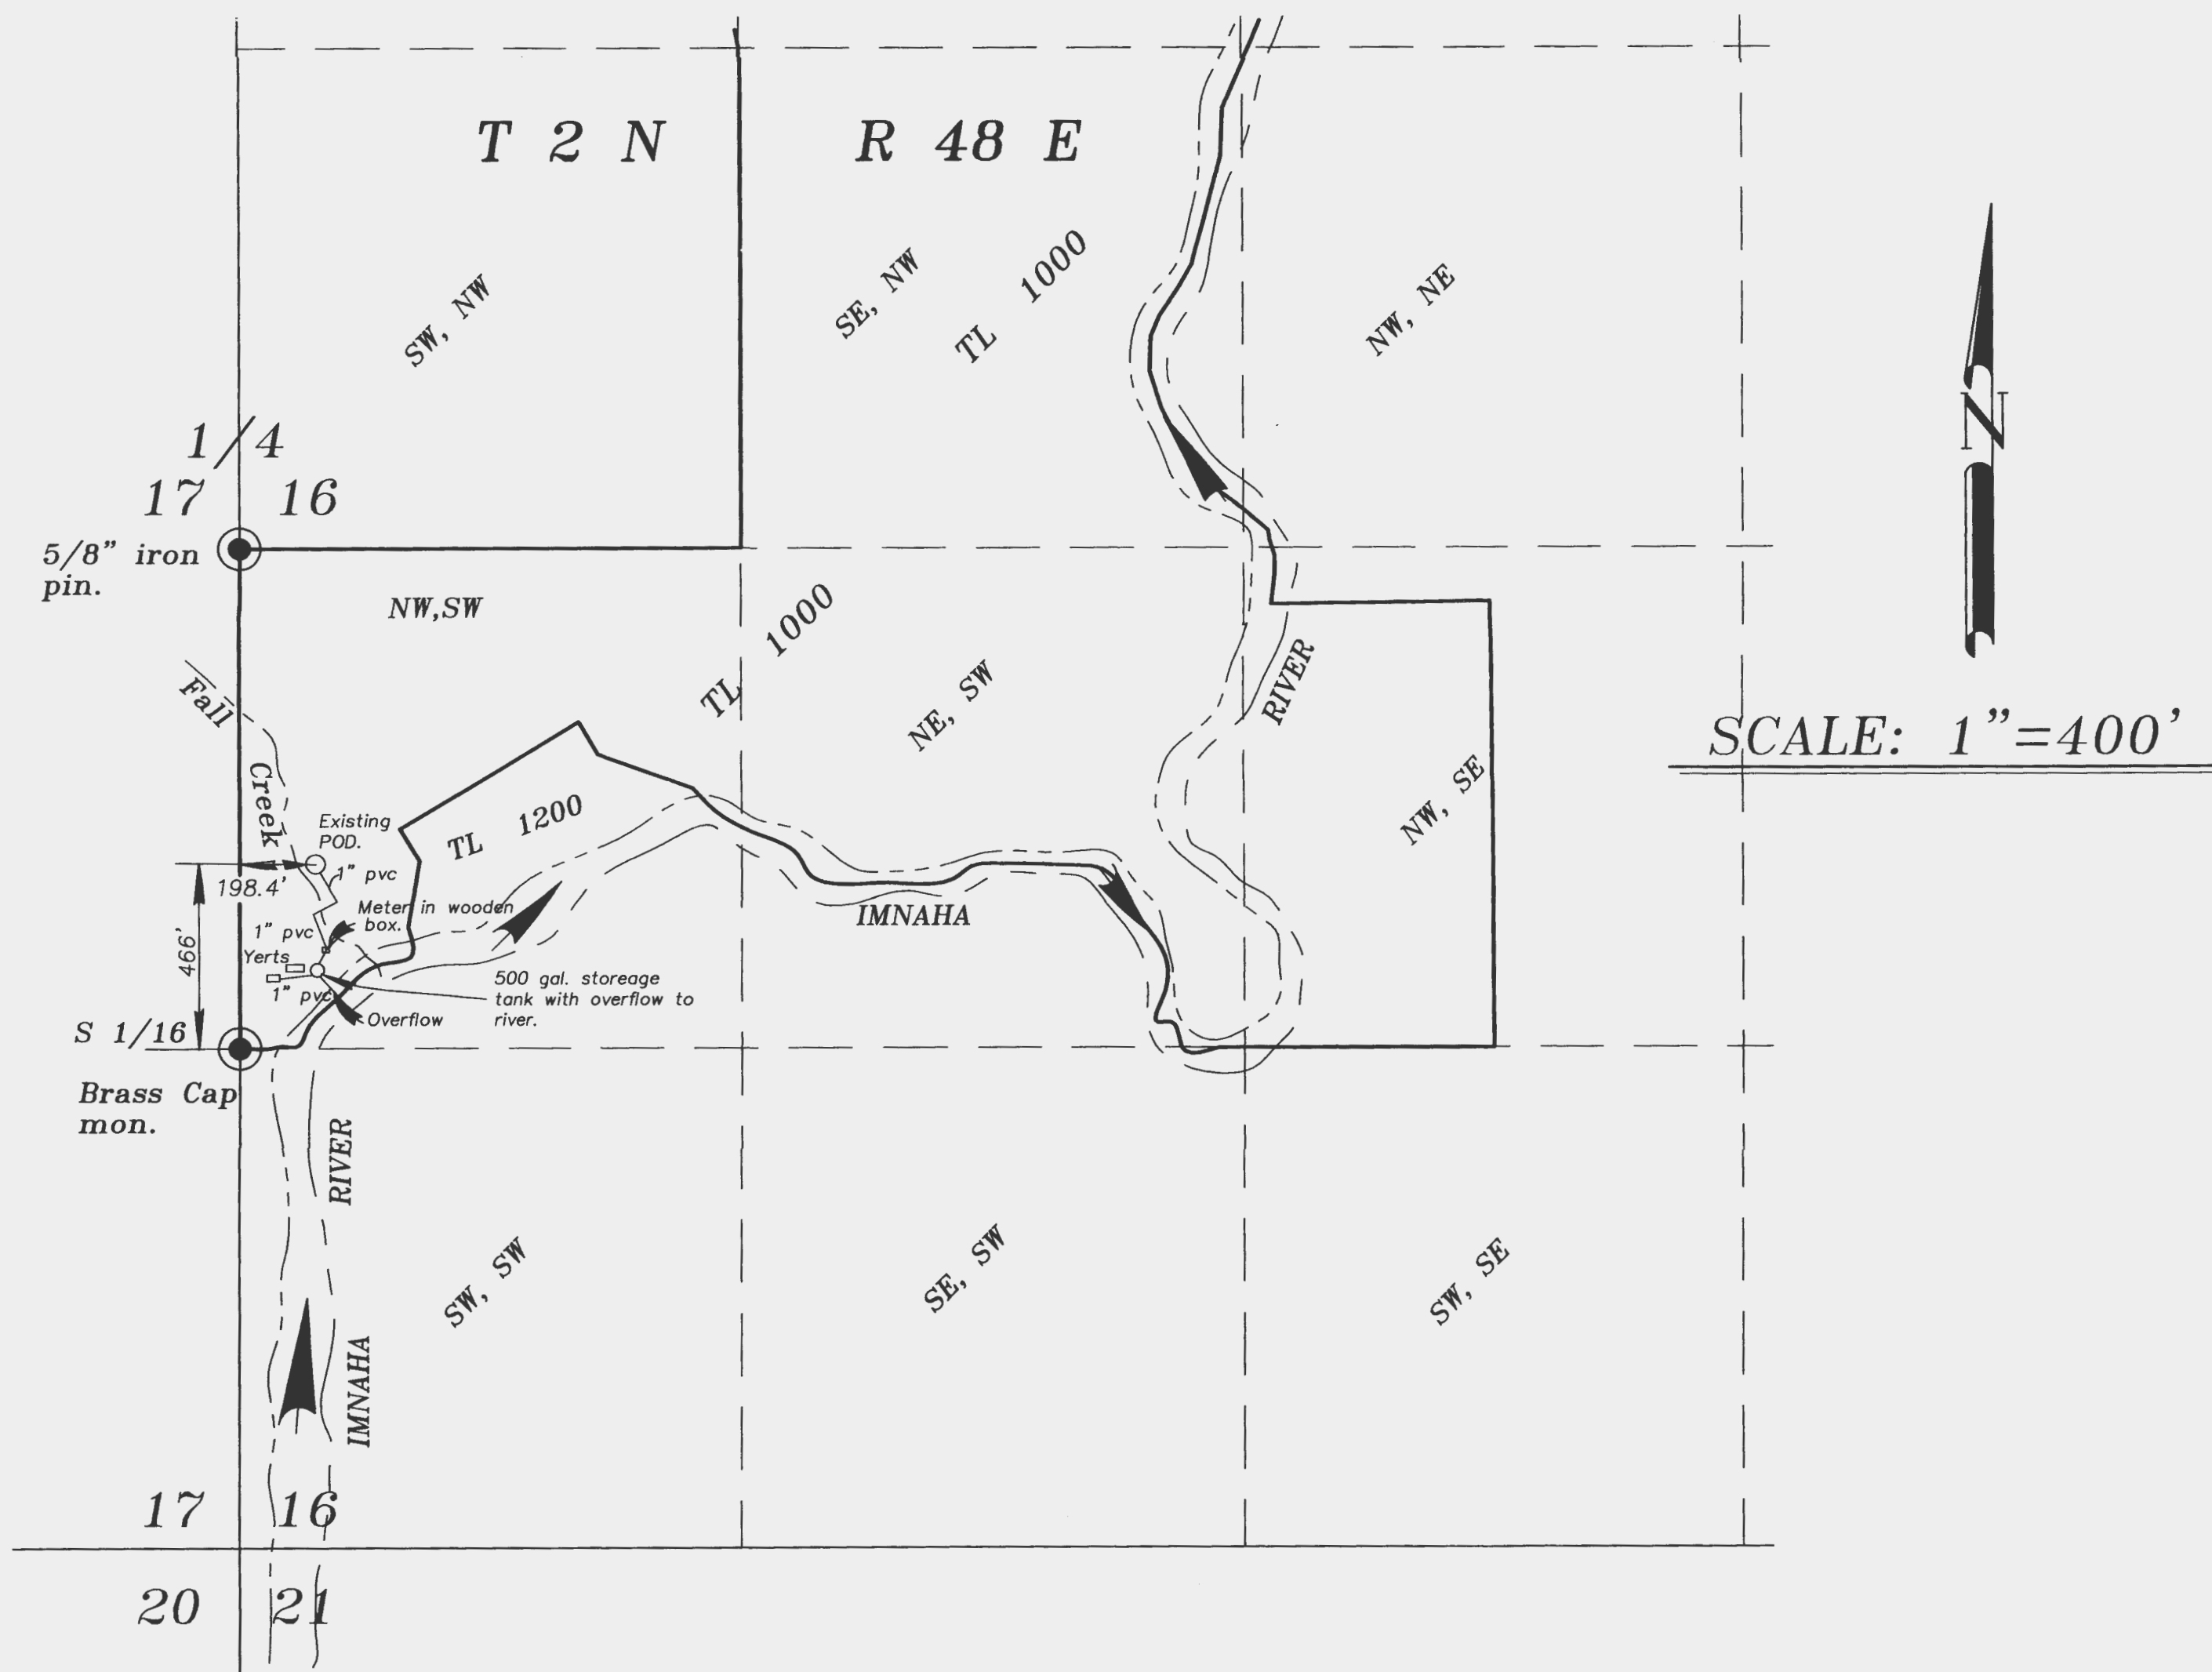

NOTE: The Point of diversion is not within the channel of Fall Creek. There is a portion of the creek that leaves the channel and flows underground through some diced rock. Mr. Weight excavated a pond about 20'x 20' and about 3' in depth into which a steady stream of water flows. I am absolutely confident that this underground stream is a part of Fall Creek. Mr. Weight installed a screen and 1" pvc pipe that flows southeasterly, crossing the Fall Creek channel and enters a wooden box with a 3/4" Hersey meter installed in June 2018.

NOTE: Survey monuments set by OXBOW SUBDIVISION as filed in the Office of the Wallowa County Clerk.

NOTE: The POD of this domestic system is the small rock dam across the south end of the existing 20 x 20 pond being North 466' and East 198.4' from the S 1/16 corner between Sections 16 and 17, Township 2N, Range 48 E, WM.

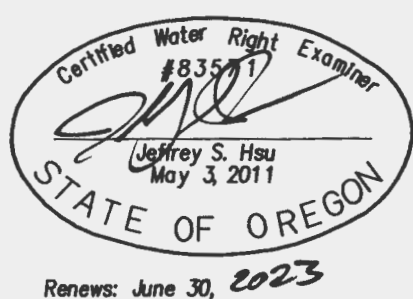

NOTE: The preparation of this map was for the purpose of identifying the location of the proposed water right and has no intent to provide dimensions or location of property ownership lines. Location information shown hereon was furnished by the applicant.

October 19, 2021
**CLAIM OF BENEFICIAL USE MAP FOR
 DOMESTIC WATER UNDER PERMIT
 P-S-55104 FROM FALL CREEK**

FOR
Harold Weight
 BY
 BAGETT - GRIFFITH & BLACKMAN
 126 RIDGE DRIVE
 LAGRANDE, OREGON 97850
 Application No. S-88112
 Permit Number S-55104

RECEIVED
 OCT 29 2021
 OWRD

MAP 1311