

# CLAIM OF BENEFICIAL USE MAP

FOR: ERIC J. & CHRISTY K. MELVIN

BY: NATHAN REED, PE, CWRE

T26S, R6W, W.M. SECTION 27 DLC 42

APPLICATION NO. S-87906

PERMIT NO. S-54911

DATE SURVEYED: SEPTEMBER 4, 2020




SCALE: 1" = 400'

RECEIVED

AN 8 0 2020

OWRD


Legend

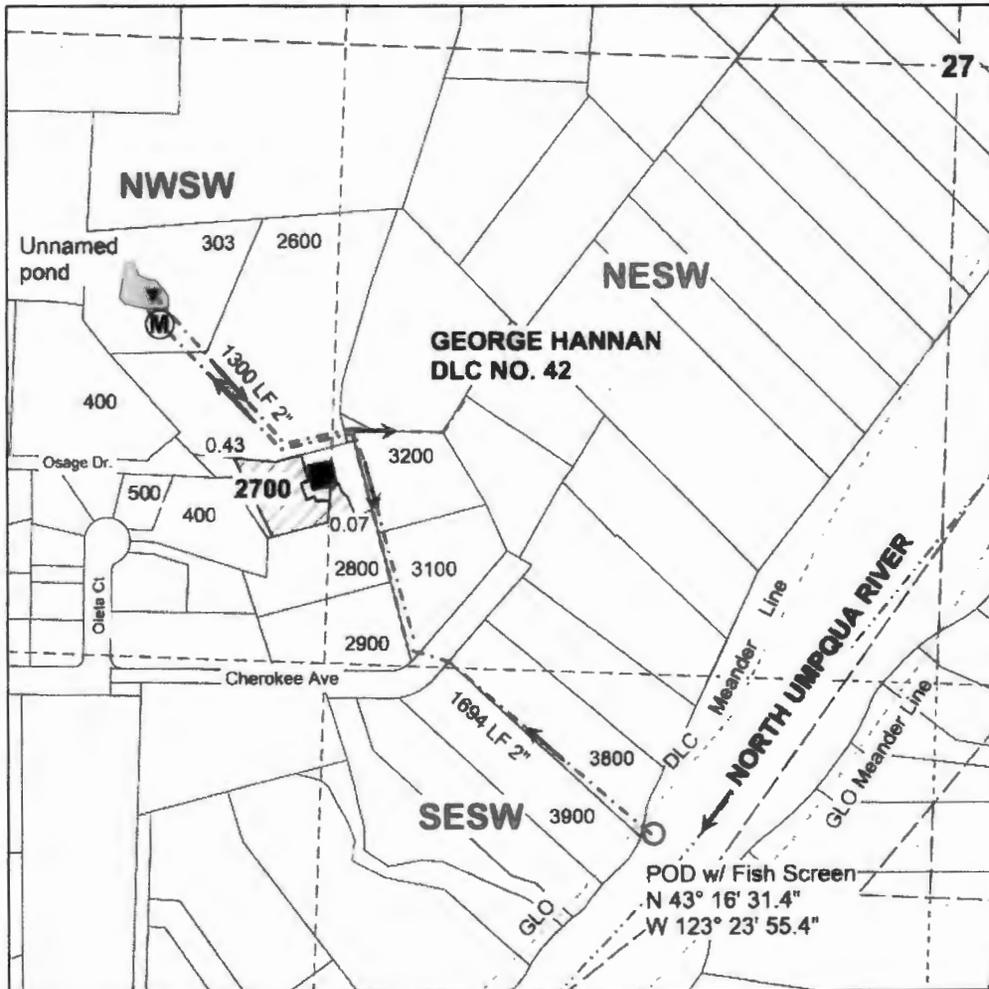

- Stream
- POD
- Pipeline
- Meter
- Pump
- Pond
- structure
- Flow arrow
- Meander
- Quarter
- Sixteenth
- Parcels

POD IS LOCATED 1640 FEET SOUTH AND 635 FEET WEST FROM THE CENTER OF SECTION 27.

MAP PREPARED FOR:  
ERIC J & CHRISTY K MELVIN  
599 CHEROKEE AVE  
ROSEBURG, OR 97471

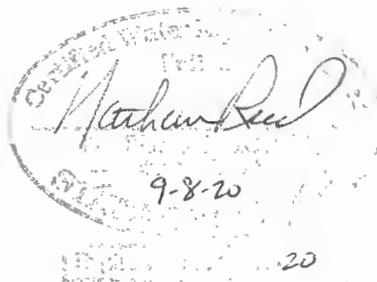

RECEIVED

FEB 26 2021

OWRD

THE PURPOSE OF THIS MAP IS TO IDENTIFY THE LOCATION OF THE WATER RIGHT. IT IS NOT INTENDED TO PROVIDE INFORMATION RELATIVE TO THE LOCATION OF PROPERTY OWNERSHIP BOUNDARY LINES.

MAP PREPARED BY:  
NATHAN R. REED, PE, CWRE  
157 WEST BODIE STREET  
ROSEBURG, OR 97471