

T. 26 S., R. 5 W., W.M.

SCALE: 1" = 400'

1/4 CORNER
SEC. 14 and 23,
T. 26 S., R. 5 W., W.M.
FD. BRASS CAP

WEST 1/4 CORNER
REPORTED AS NOT FOUND
BY DOUGLAS CO. 4/1984

CONTROL PANEL
with 4 G.P.M. INLINE
FLOW RESTRICTOR

P.O.D. with
FISH SCREEN



NW SW
SEC. 23
USE
DOMESTIC EXPANDED

SW SW
SEC. 23

LEGEND

- ▲ COMPUTED POINT
- FD. Survey Monument
- ⊙ FD. Govn. corner
- P.O.D. or as noted
- PROPERTY LINES
- - - 40 LINES

UNIPQUA RIVER


NORTH

UP TO 1/2 AC.
LAWN AREA

BURIED
PIPELINE

HOME

T.L. 3800,
SEC. 14C,
T. 26S., R. 5 W., W.M.

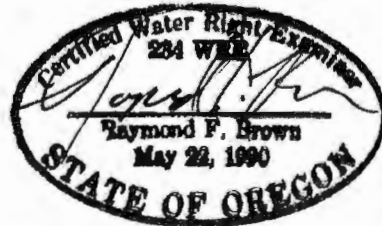

RENEWS 12/31/2021

NE SW
SEC. 23

RECEIVED

SE SW
SEC. 23

FEB 08 2021

OWNED

FINAL PROOF SURVEY

UNDER

Application No. S-88019

Permit No. S-54927

IN NAME OF

ROBERT FISCHER

Surveyed; APR. 07, 2020

by: R.F. BROWN

P.O.D. IS 2945 FEET SOUTH AND 1823 FEET WEST
OF THE QUARTER CORNER COMMON TO SECTIONS
14 AND 23, TOWNSHIP 26 SOUTH, RANGE 5 WEST,
WILLAMETTE MERIDIAN.

THE PURPOSE OF THIS MAP IS TO IDENTIFY THE
LOCATION OF THE WATER RIGHT. IT IS NOT INTENDED TO
PROVIDE INFORMATION RELATIVE TO THE LOCATION OF
PROPERTY OWNERSHIP BOUNDARY LINES.