

**T25S R33E, WM,
HARNEY COUNTY, OR**



0 1,320 Feet

1" = 1320'

⊙ APOA Well & Meter

⊙ Authorized Well & Meter

 POU IR

 Township

 Section

 Quarter Quarter

 Tax Lot

Well Locations:


Well #1 (HARN 50238/L-21128:
1324' S, 1349' W of NE Cor Sec 25

Well #2 (HARN 51629/L-84791:
100' S, 510' W of NE Cor Sec 25

RECEIVED

MAR 28 2022

OWRD

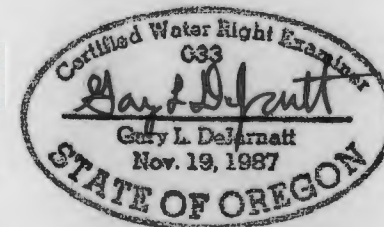

RENEWAL DATE 12/31/2023



**CLAIM OF BENEFICIAL USE MAP
BOWYER-PECK RANCHES, LLC**

T-13617

Project #21048

Date: 3/7/2022

This map is not intended
to provide legal dimensions
or locations of property
ownership lines.

WATER RIGHT SERVICES, LLC
PO BOX 1830, BEND, OR 97709
WWW.OREGONWATER.US CCB # 197121
johnshort@usa.com 541-389-2837