

Map For Claim of Beneficial Use


Sections 33, T4S, R4W, & 4, T5S, R4W, Yamhill County
T-13232

RECEIVED

SEP 24 2020



OWRD

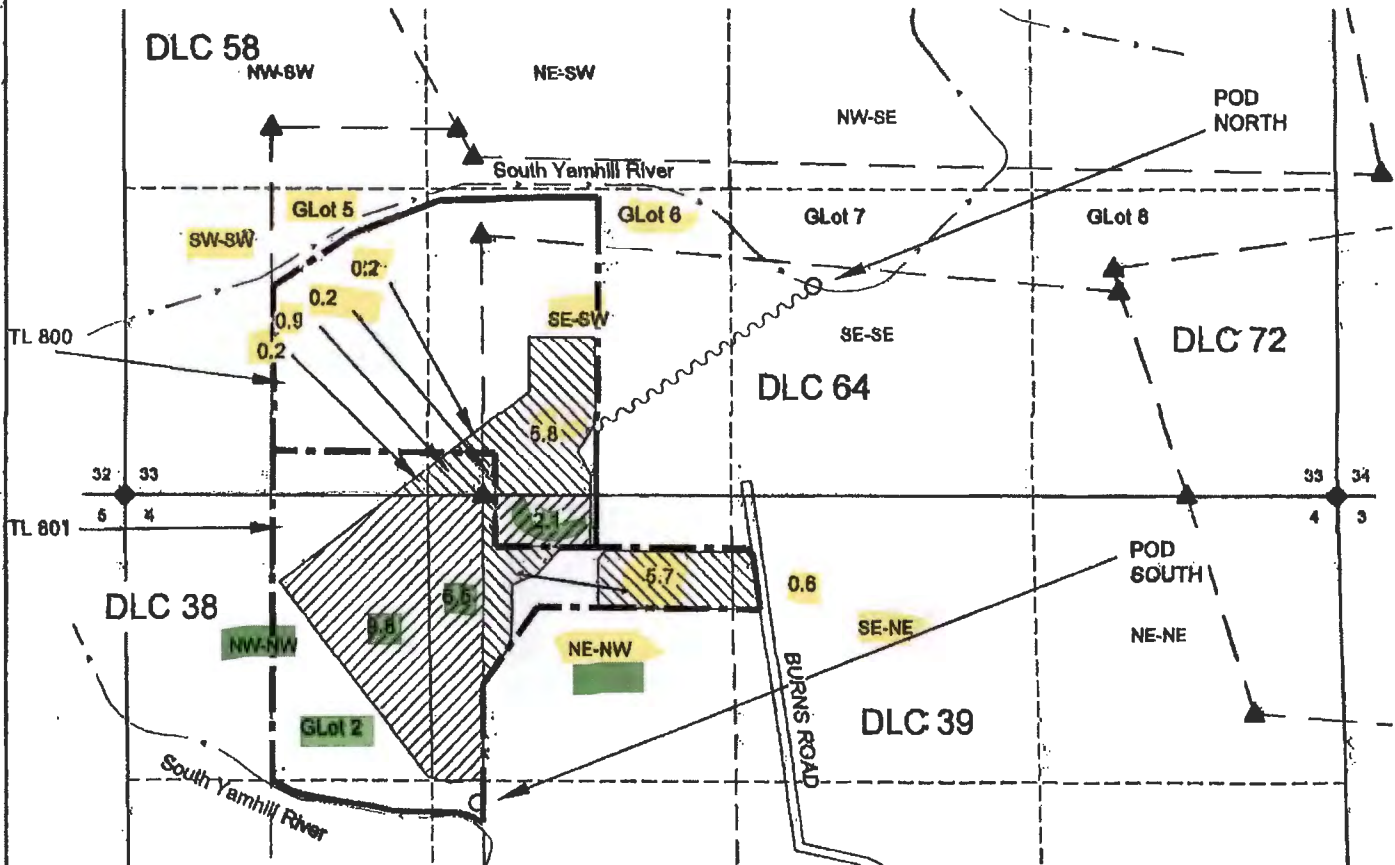

NOTES:


- THIS MAP IS NOT INTENDED TO PROVIDE LEGAL DIMENSIONS OR LOCATIONS OF PROPERTY OWNERSHIP LINES.
- COUNTY SURVEY 14020 WAS USED AS A BASIS TO SCALE THE TAX ASSESSOR MAPS FOR S28 & S33 T4S, R4W, AND S4 T6S, R4W. PROPERTY LINES, DONATION LAND CLAIM LINES, AND QUARTER-QUARTER LINES ARE BASED ON THOSE TAX ASSESSOR MAPS.
- THE TAX LOT NUMBERS ARE BASED ON THE MAP FOR S33, T4S, R4W.
- A GOOGLE AERIAL PHOTO WAS THEN SCALED FOR PHOTO INTERPRETATION OF OTHER FEATURES.

LEGEND

- DONATION LAND CLAIM (DLC) CORNER
- SECTION CORNER
- POINT OF DIVERSION
- STREAM OR SURFACE DRAINAGE
- TAX LOT LINE
- SECTION LINE
- QUARTER-QUARTER LINE
- DLC LINES
- CONVEYANCE PIPELINES.



Cert. 15391 TO lands
Cert. 15392 TO lands

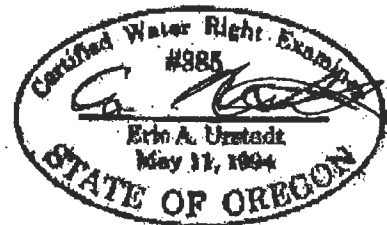

MAP BY:
ASPEN RURAL LAND CONSULTING
ERIC URSTADT, PE, PLS
971-260-1620
Sep 2020
WVL-Burns4B