

Map For Claim of Beneficial Use



Sections 33, T4S, R4W, & 4, T5S, R4W, Yamhill County
T-13232

RECEIVED

SEP 24 2020



OWRD

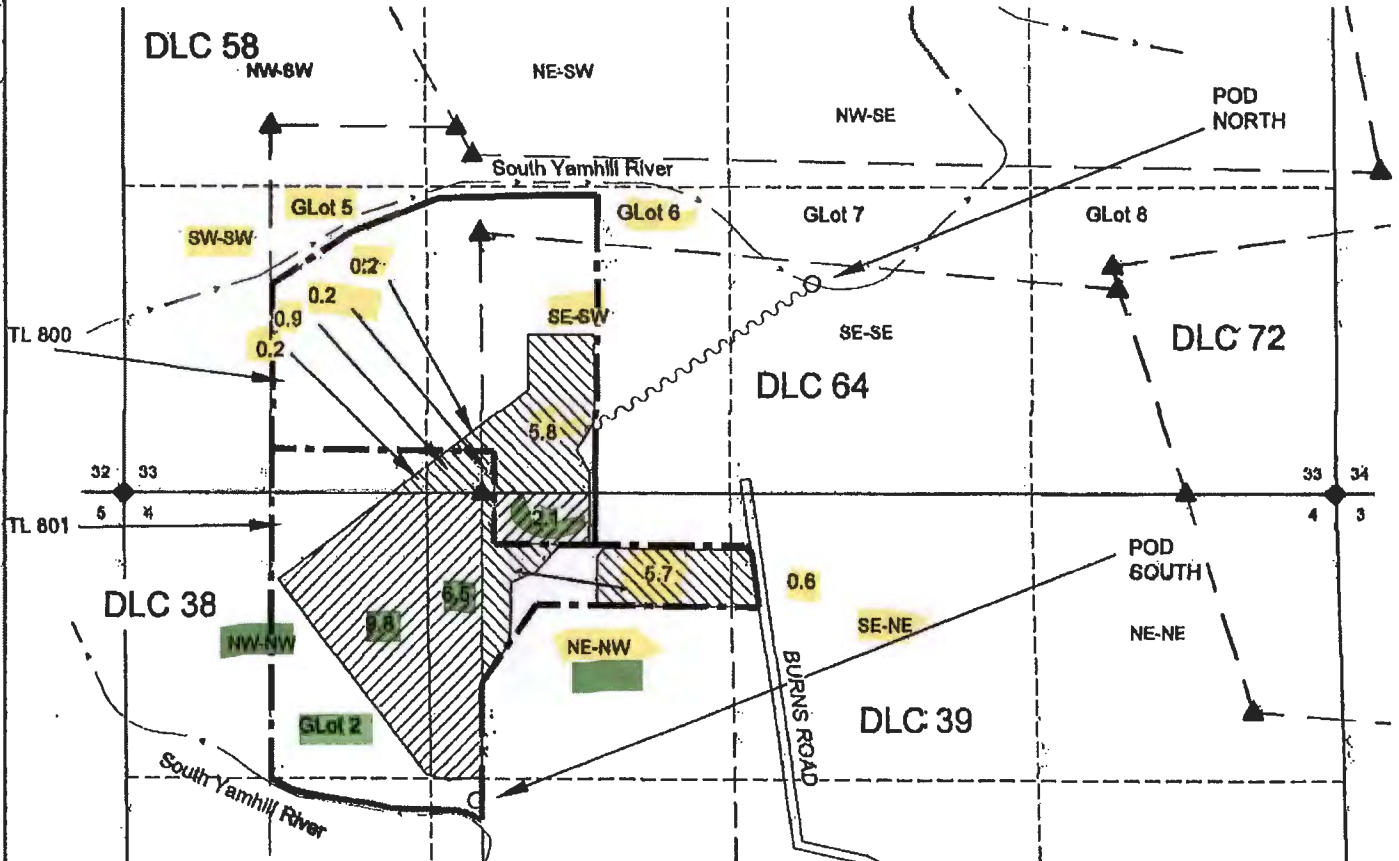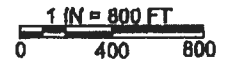


NOTES:

THIS MAP IS NOT INTENDED TO PROVIDE LEGAL DIMENSIONS OR LOCATIONS OF PROPERTY OWNERSHIP LINES.
-COUNTY SURVEY 14020 WAS USED AS A BASIS TO SCALE THE TAX ASSESSOR MAPS FOR S28 & S33 T4S, R4W, AND S4 T6S, R4W. PROPERTY LINES, DONATION LAND CLAIM LINES, AND QUARTER-QUARTER LINES ARE BASED ON THOSE TAX ASSESSOR MAPS.
-THE TAX LOT NUMBERS ARE BASED ON THE MAP FOR S33, T4S, R4W.
-A GOOGLE AERIAL PHOTO WAS THEN SCALED FOR PHOTO INTERPRETATION OF OTHER FEATURES.

- LEGEND**
- ▲ DONATION LAND CLAIM (DLC) CORNER
 - ◆ SECTION CORNER
 - POINT OF DIVERSION
 - - - - - STREAM OR SURFACE DRAINAGE
 - — — — TAX LOT LINE
 - — — — SECTION LINE
 - - - - - QUARTER-QUARTER LINE
 - - - - - DLC LINES
 - ~~~~~ CONVEYANCE PIPELINES.

- Cert. 15391 TO lands
- Cert. 15392 TO lands

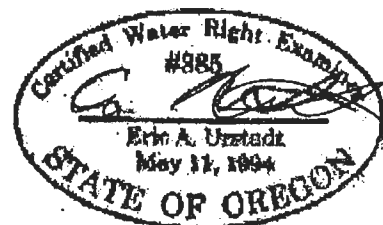

MAP BY:
ASPEN RURAL LAND CONSULTING
ERIC URSTADT, PE, PLS
971-260-1520
Sep 2020
WWL-Burns4B