

HE-247

TOWNSHIP T9S
RANGE R7E
SECTION 20

PROJECT
LOCATION

SCALE

4" = 1 mi.

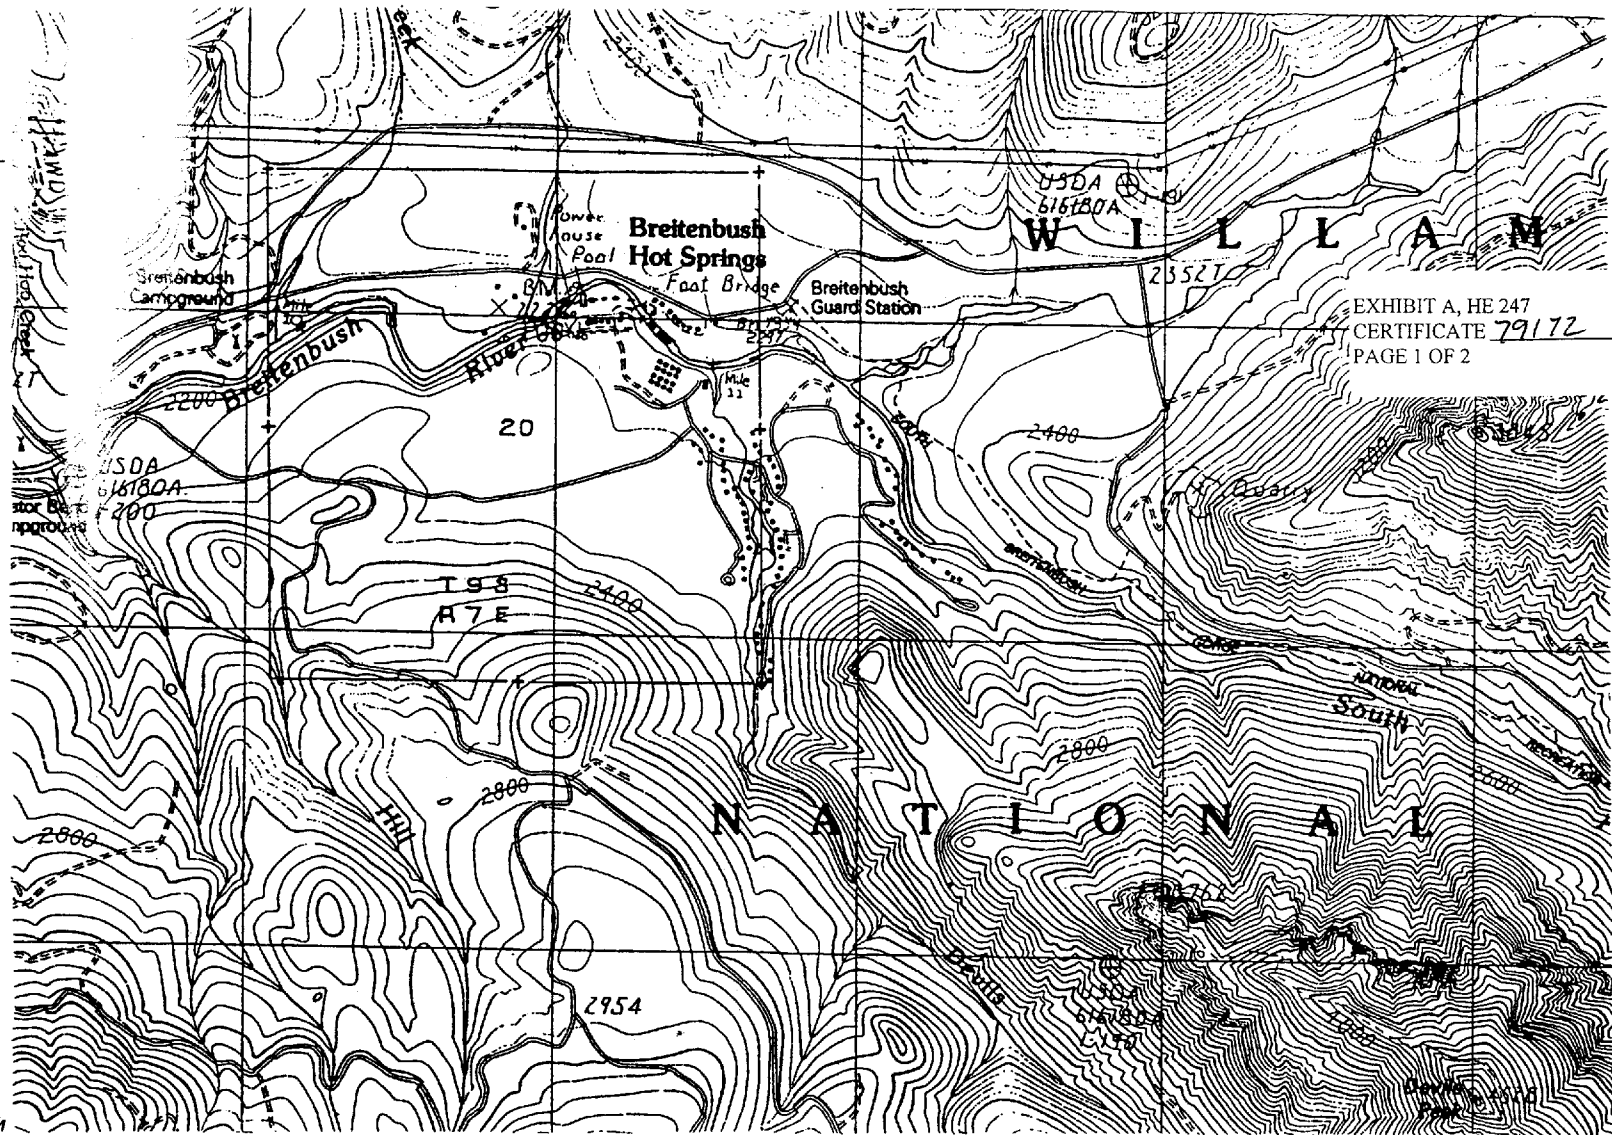



EXHIBIT A, HE 247
CERTIFICATE 79172
PAGE 1 OF 2

RECEIVED
FEB 27 1998
WATER RESOURCES DEPT.
SALEM, OREGON

RECEIVED

FEB 27 1998

WATER RESOURCES DEPT
SALEM, OREGON

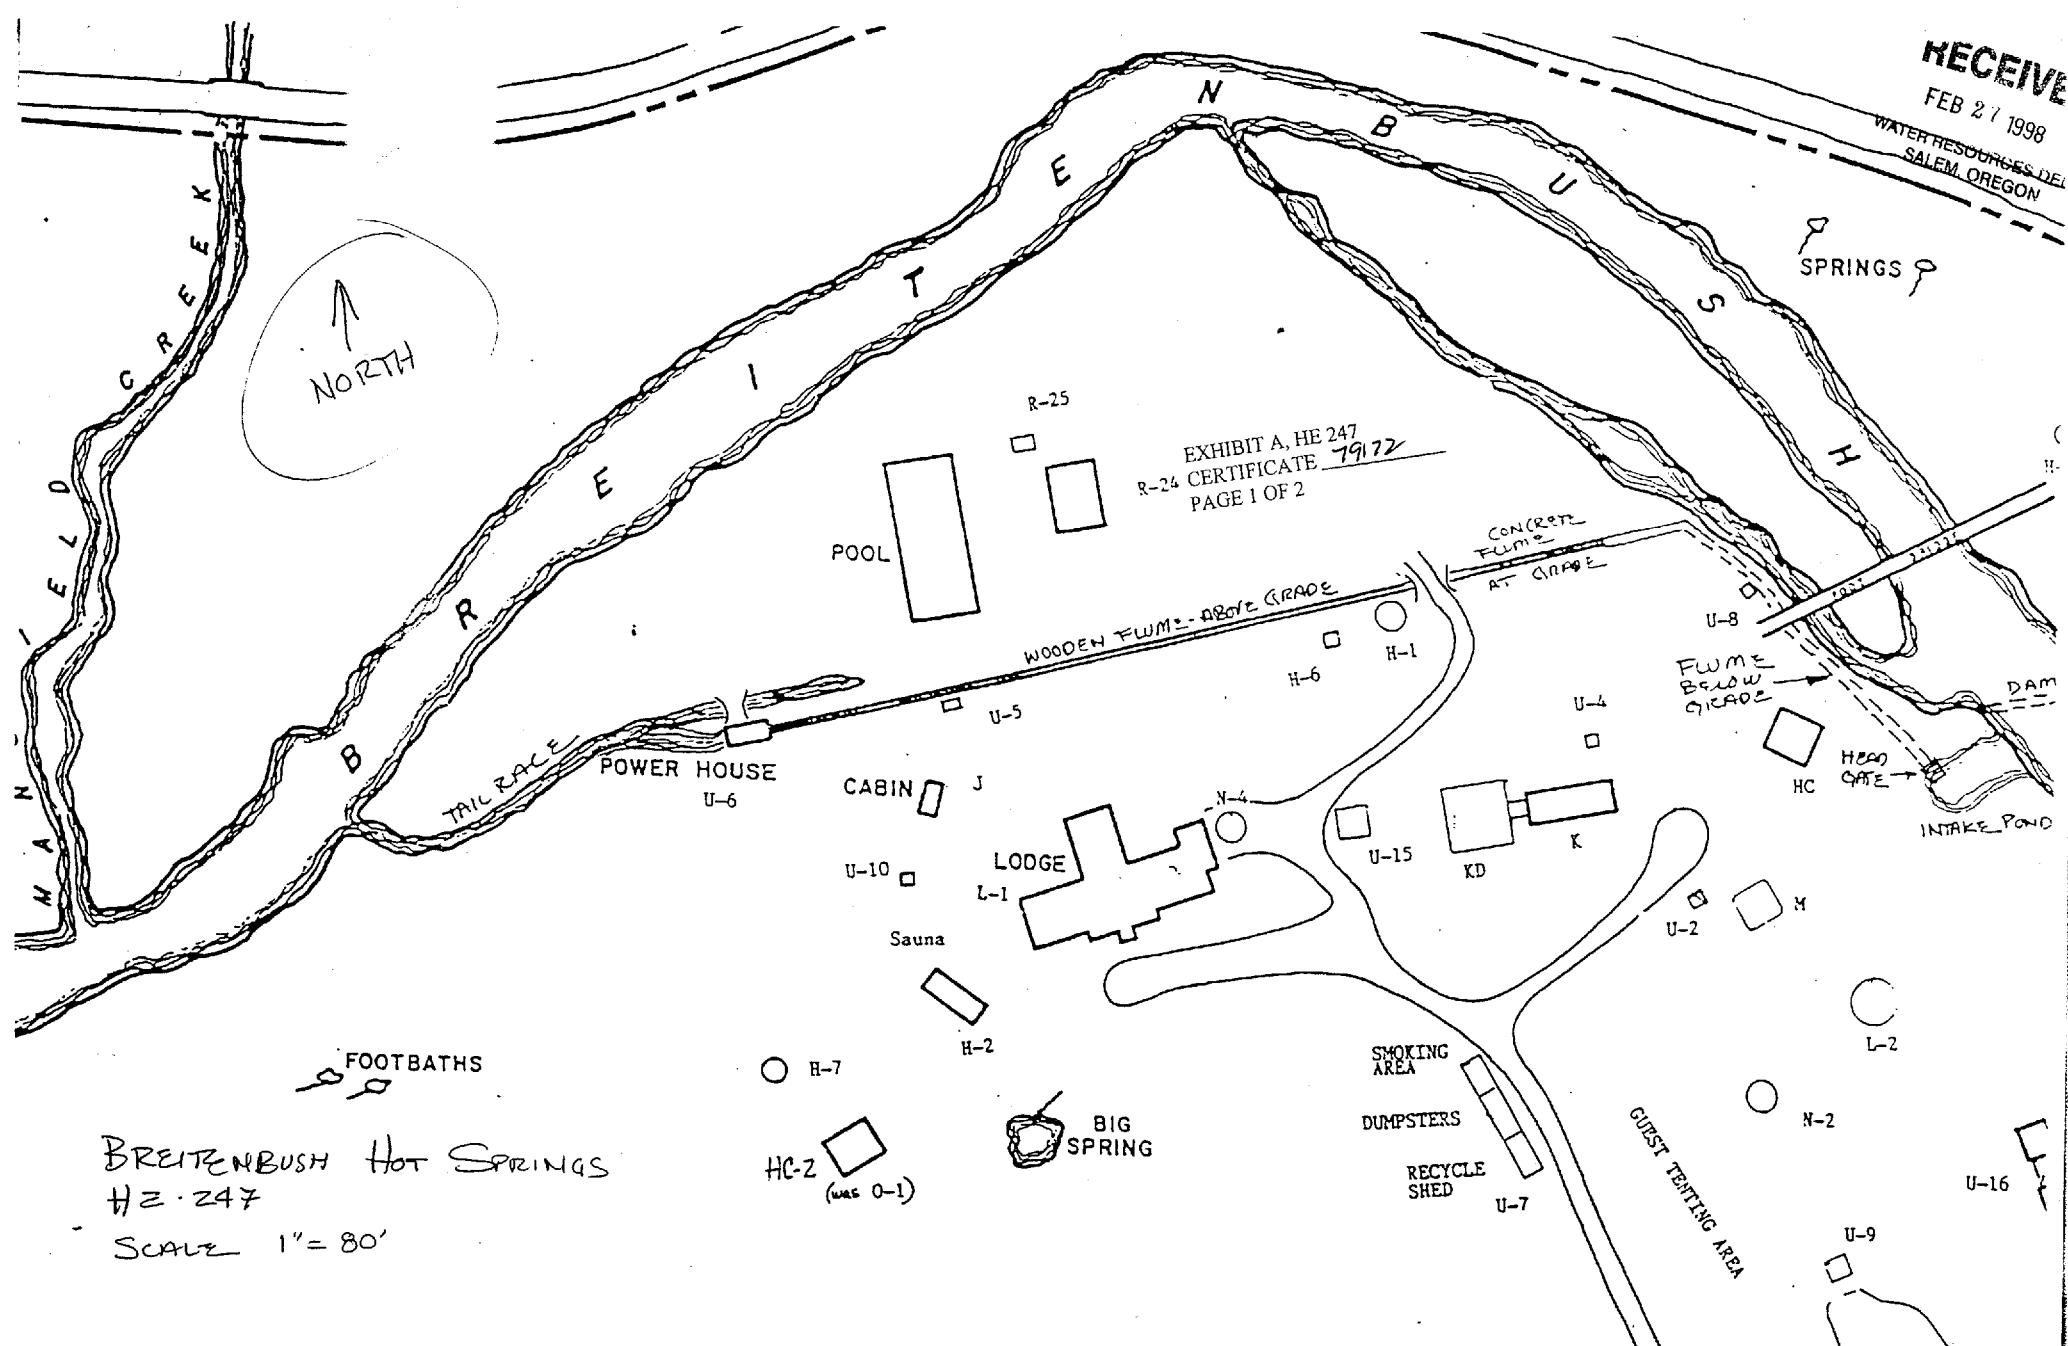

BREITENBUSH HOT SPRINGS

HZ-247

SCALE 1" = 80'