

CLAIM OF BENEFICIAL USE MAP  
For  
RESERVOIR APPLICATION R-87496 & PERMIT R-14830  
PERMIT AMMENDMENT T-11435 (Volume)


RECEIVED

MAY 27 2021


OWRD

DONATIIION LAND CLAIM 48  
Sections 27 & 28, Township 5 South, Range 4 West of WM

STEVEN M. & ROSALBA M. GOFFENA PROPERTY

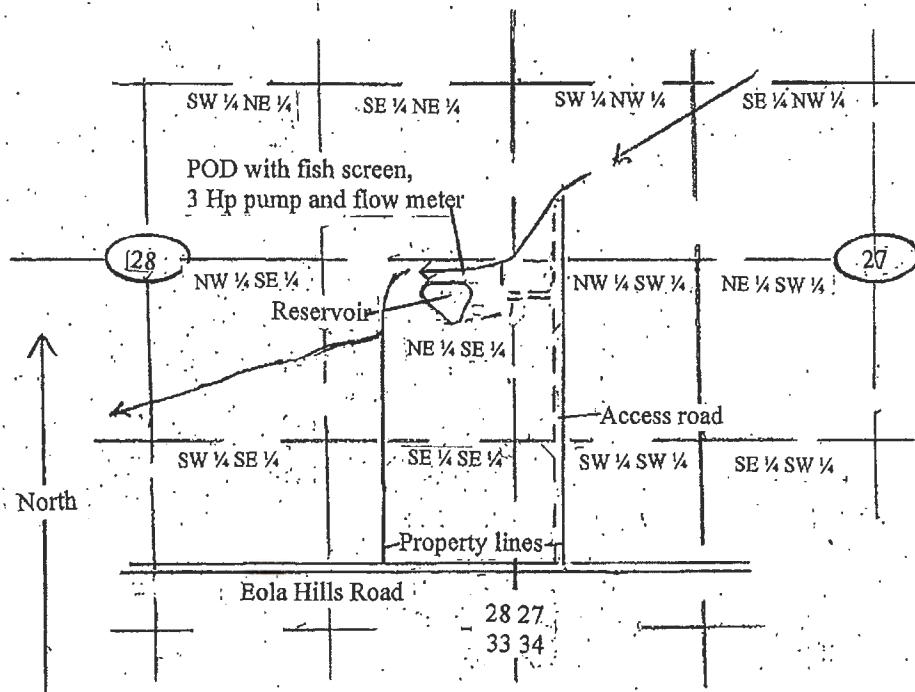

POD 350' West and 50' South of East 1/4 Corner Section 28  
(45° 06.5' North Latitude and 123° 10.6' West Longitude)

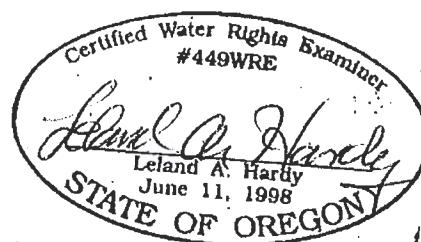

RENEWAL DATE: 6/21

The purpose of this map is to identify the location of an existing POD and water use. It is not intended to provide information relative to the location of property ownership boundary lines.