


**T23S R32E, WM
HARNEY COUNTY, OR**

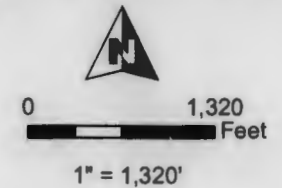

- Well & Meter
- Pipeline
- POU IR (from C-48659) 7/6/1973 Priority
- POU IR (from C-48660) 9/1/1976 Priority
- POU IR (from C-92120) 9/9/1994 Priority
- Section
- Quarter Quarter
- Tax Lot


RECEIVED

JUN 21 2022

OWRD

Well Locations:

Well #1 (HARN 2032): 60' N, 1315' E of SW Cor Sec 2
 Well #4/Raine Well (HARN 558): 880' S, 70' E of NW Cor Sec 11
 Well #5 (HARN 50898/L-53105): 1650' S, 110' E of W 1/4 Cor Sec 11

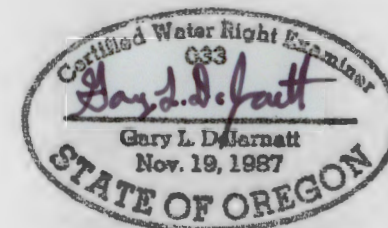

RENEWAL DATE 12/31/2023



**CLAIM OF BENEFICIAL USE MAP
Roger and Mindy Sheley**

Date: 5/19/2022

T-13257

Project #22013

This map is not intended
to provide legal dimensions
or locations of property
ownership lines.

WATER RIGHT SERVICES, LLC
 PO BOX 1830, BEND, OR 97709
WWW.OREGONWATER.US CCB # 197121
 johnshort@usa.com 541-389-2837