


T. 25 S., R. 6 W., W. M.

Scale: 1" = 1000'

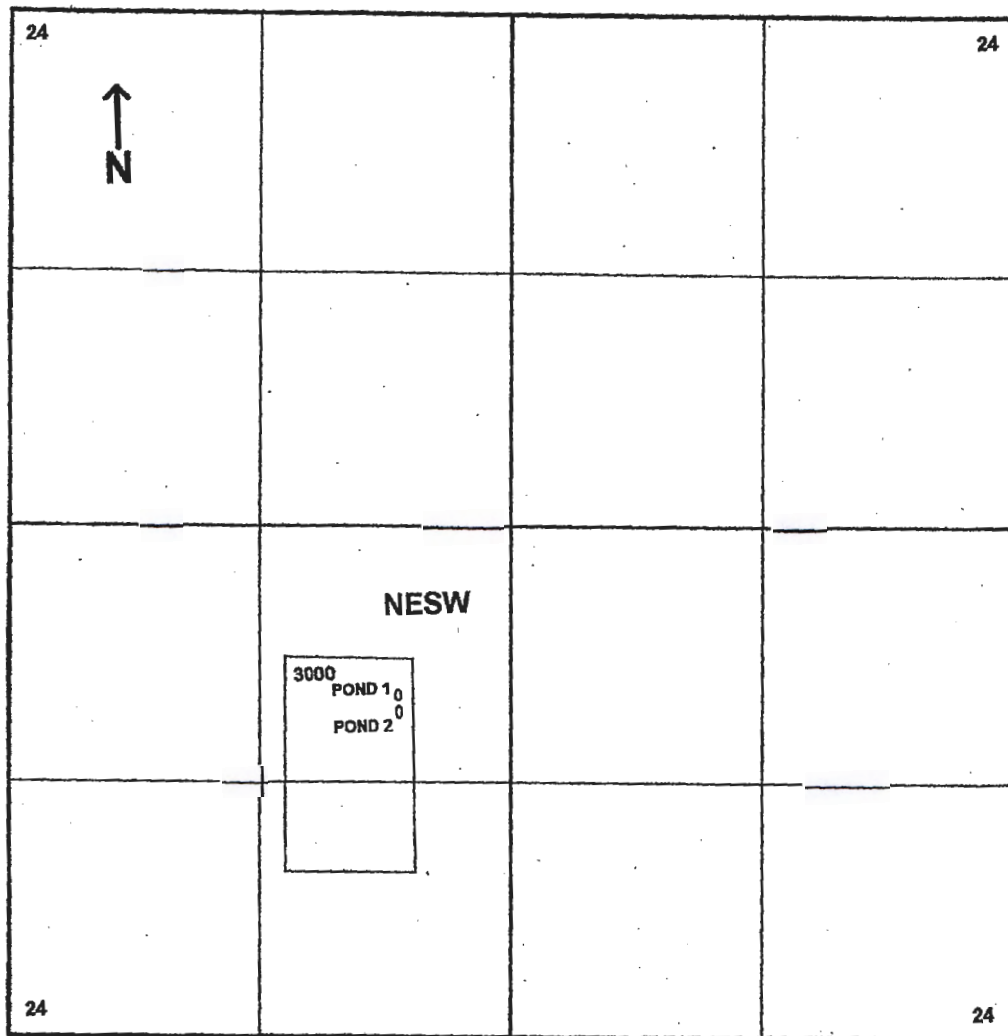

POND 1 - 860 ft. S. and 580 ft. W. } from the center of Sec. 24
POND 2 - 950 ft. S. and 580 ft. W.

RECEIVED

OCT 30 2020

OWRD

RECEIVED

JUL 14 2008

**WATER RESOURCES DEPT
SALEM, OREGON**

App No B87223 Permit No R 14685